


S.E. 1/4 Sec. 26—29—22

BEAVER LAKE

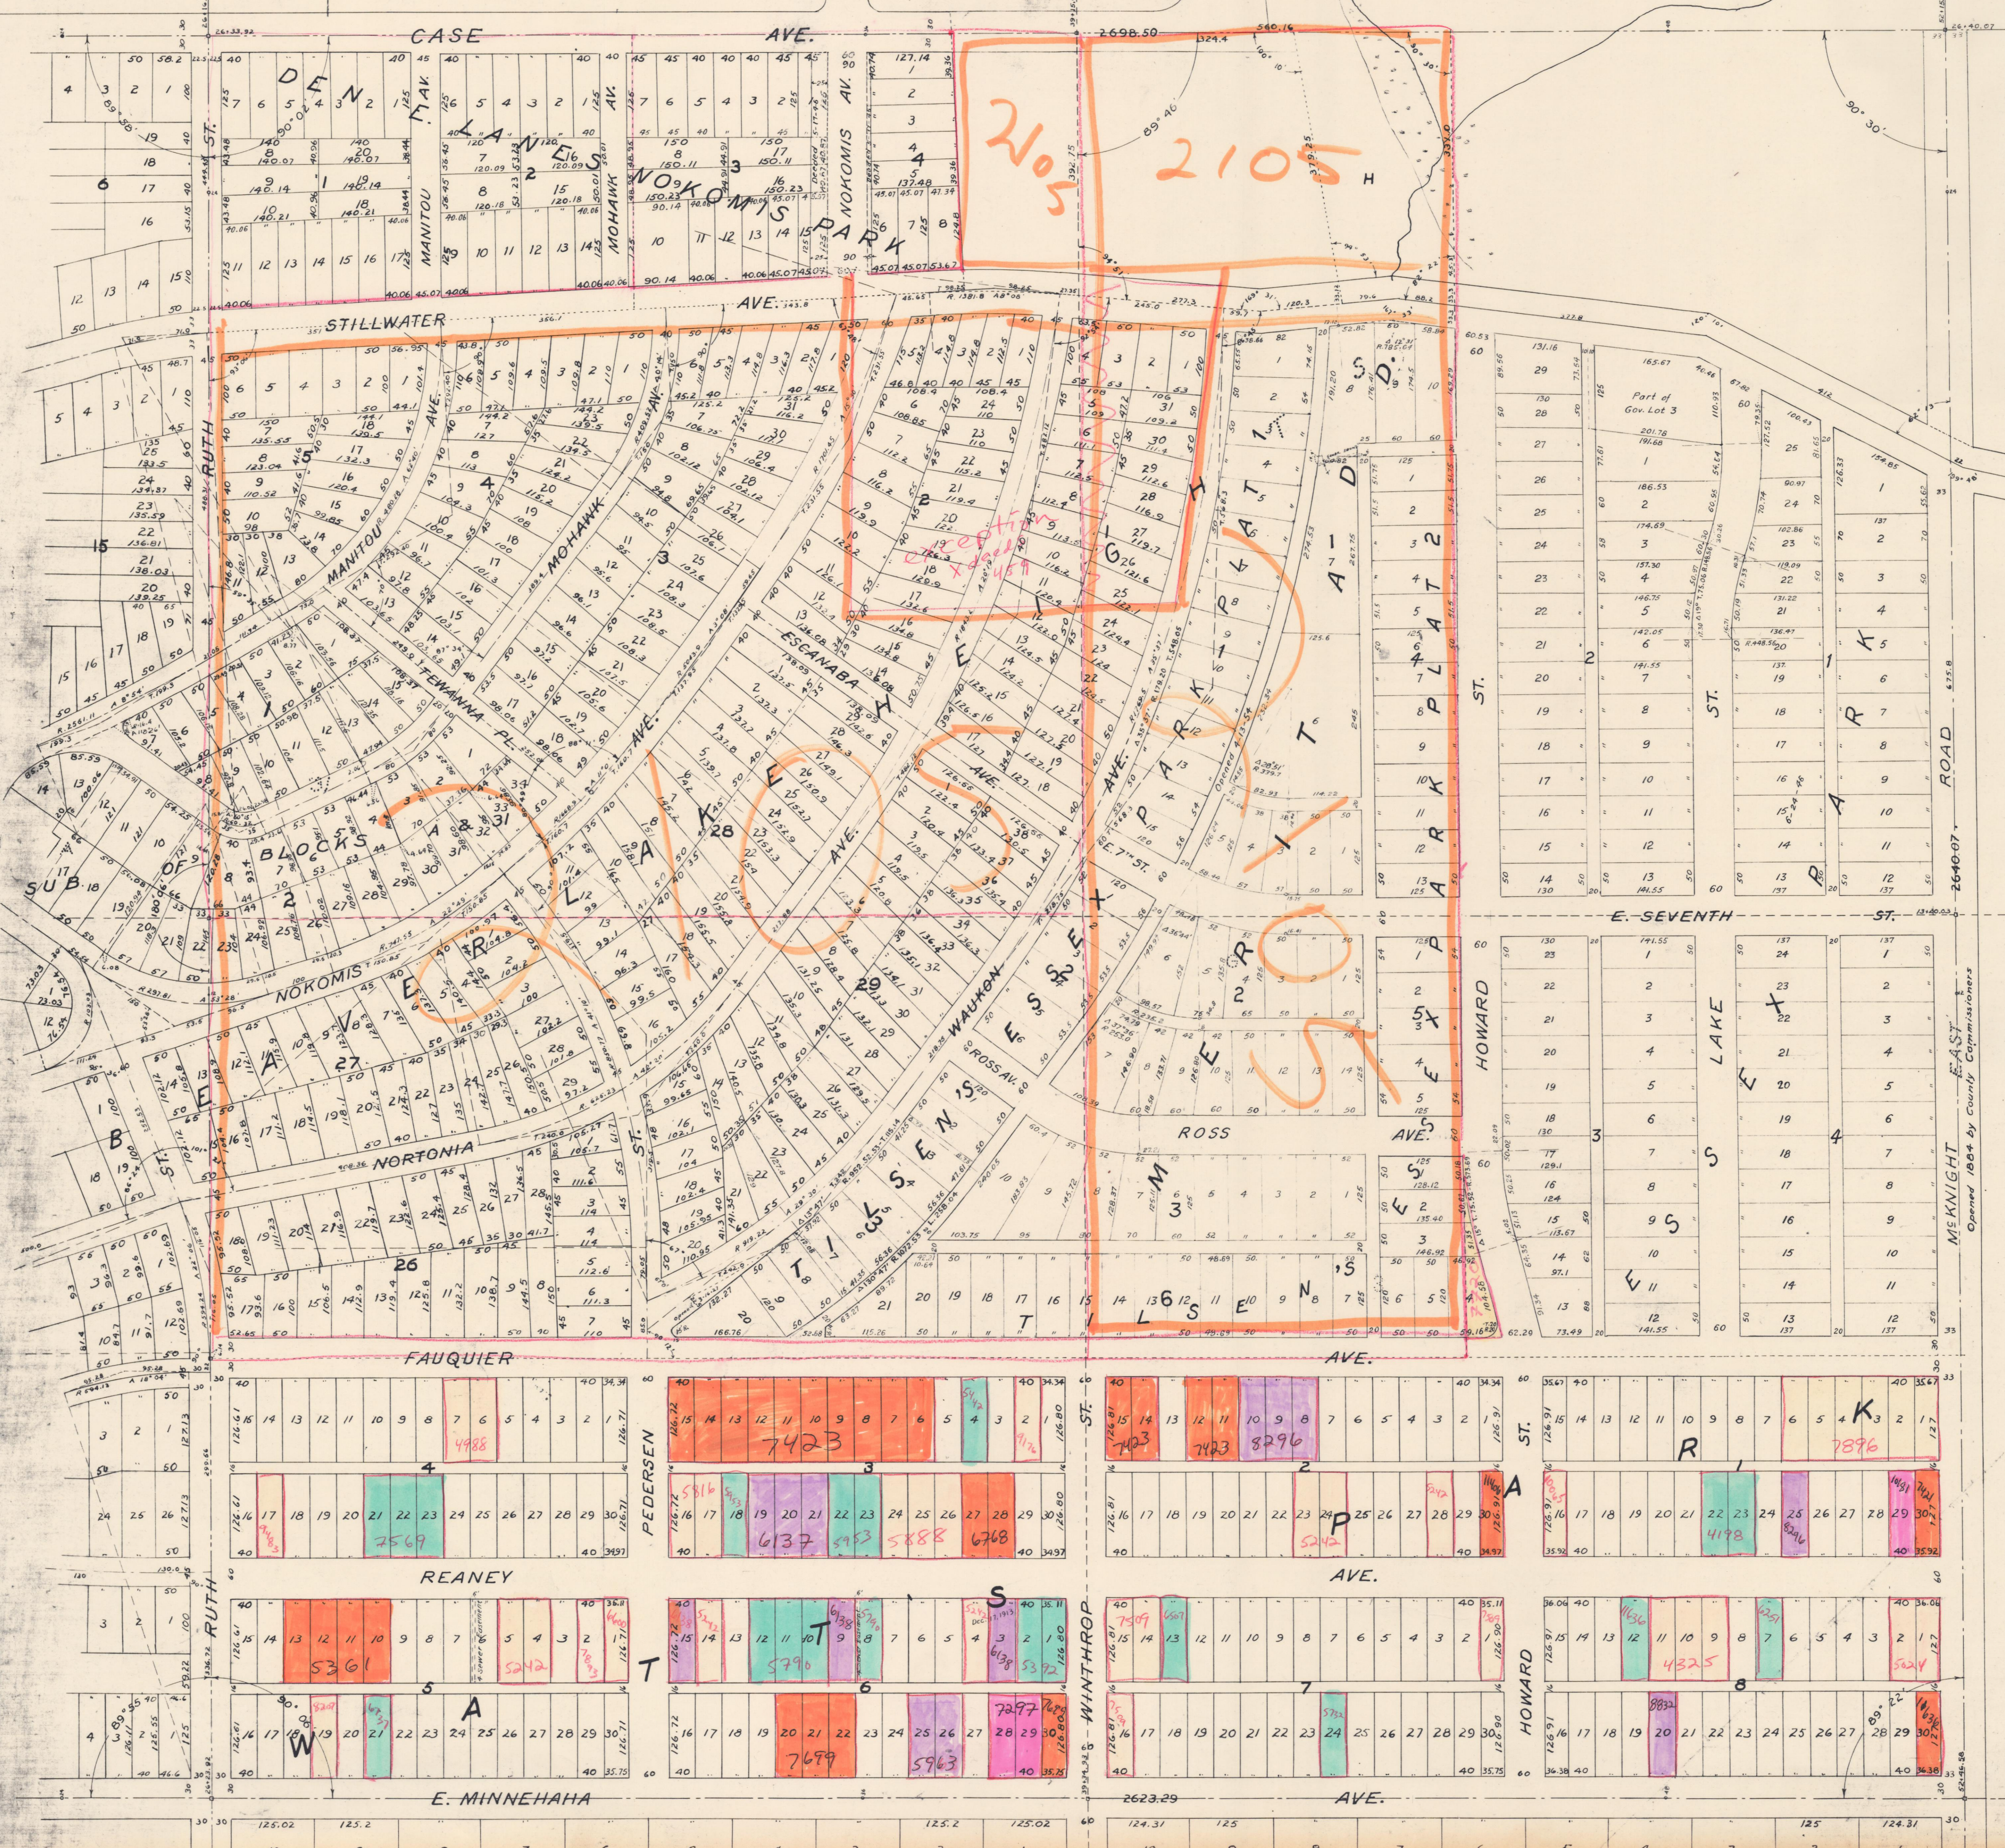

S.E. 1/4 26-29-22

McKnight
Opened 1904 by County Commissioners