


S.W. 1/4 Sec. 29 - 29-22

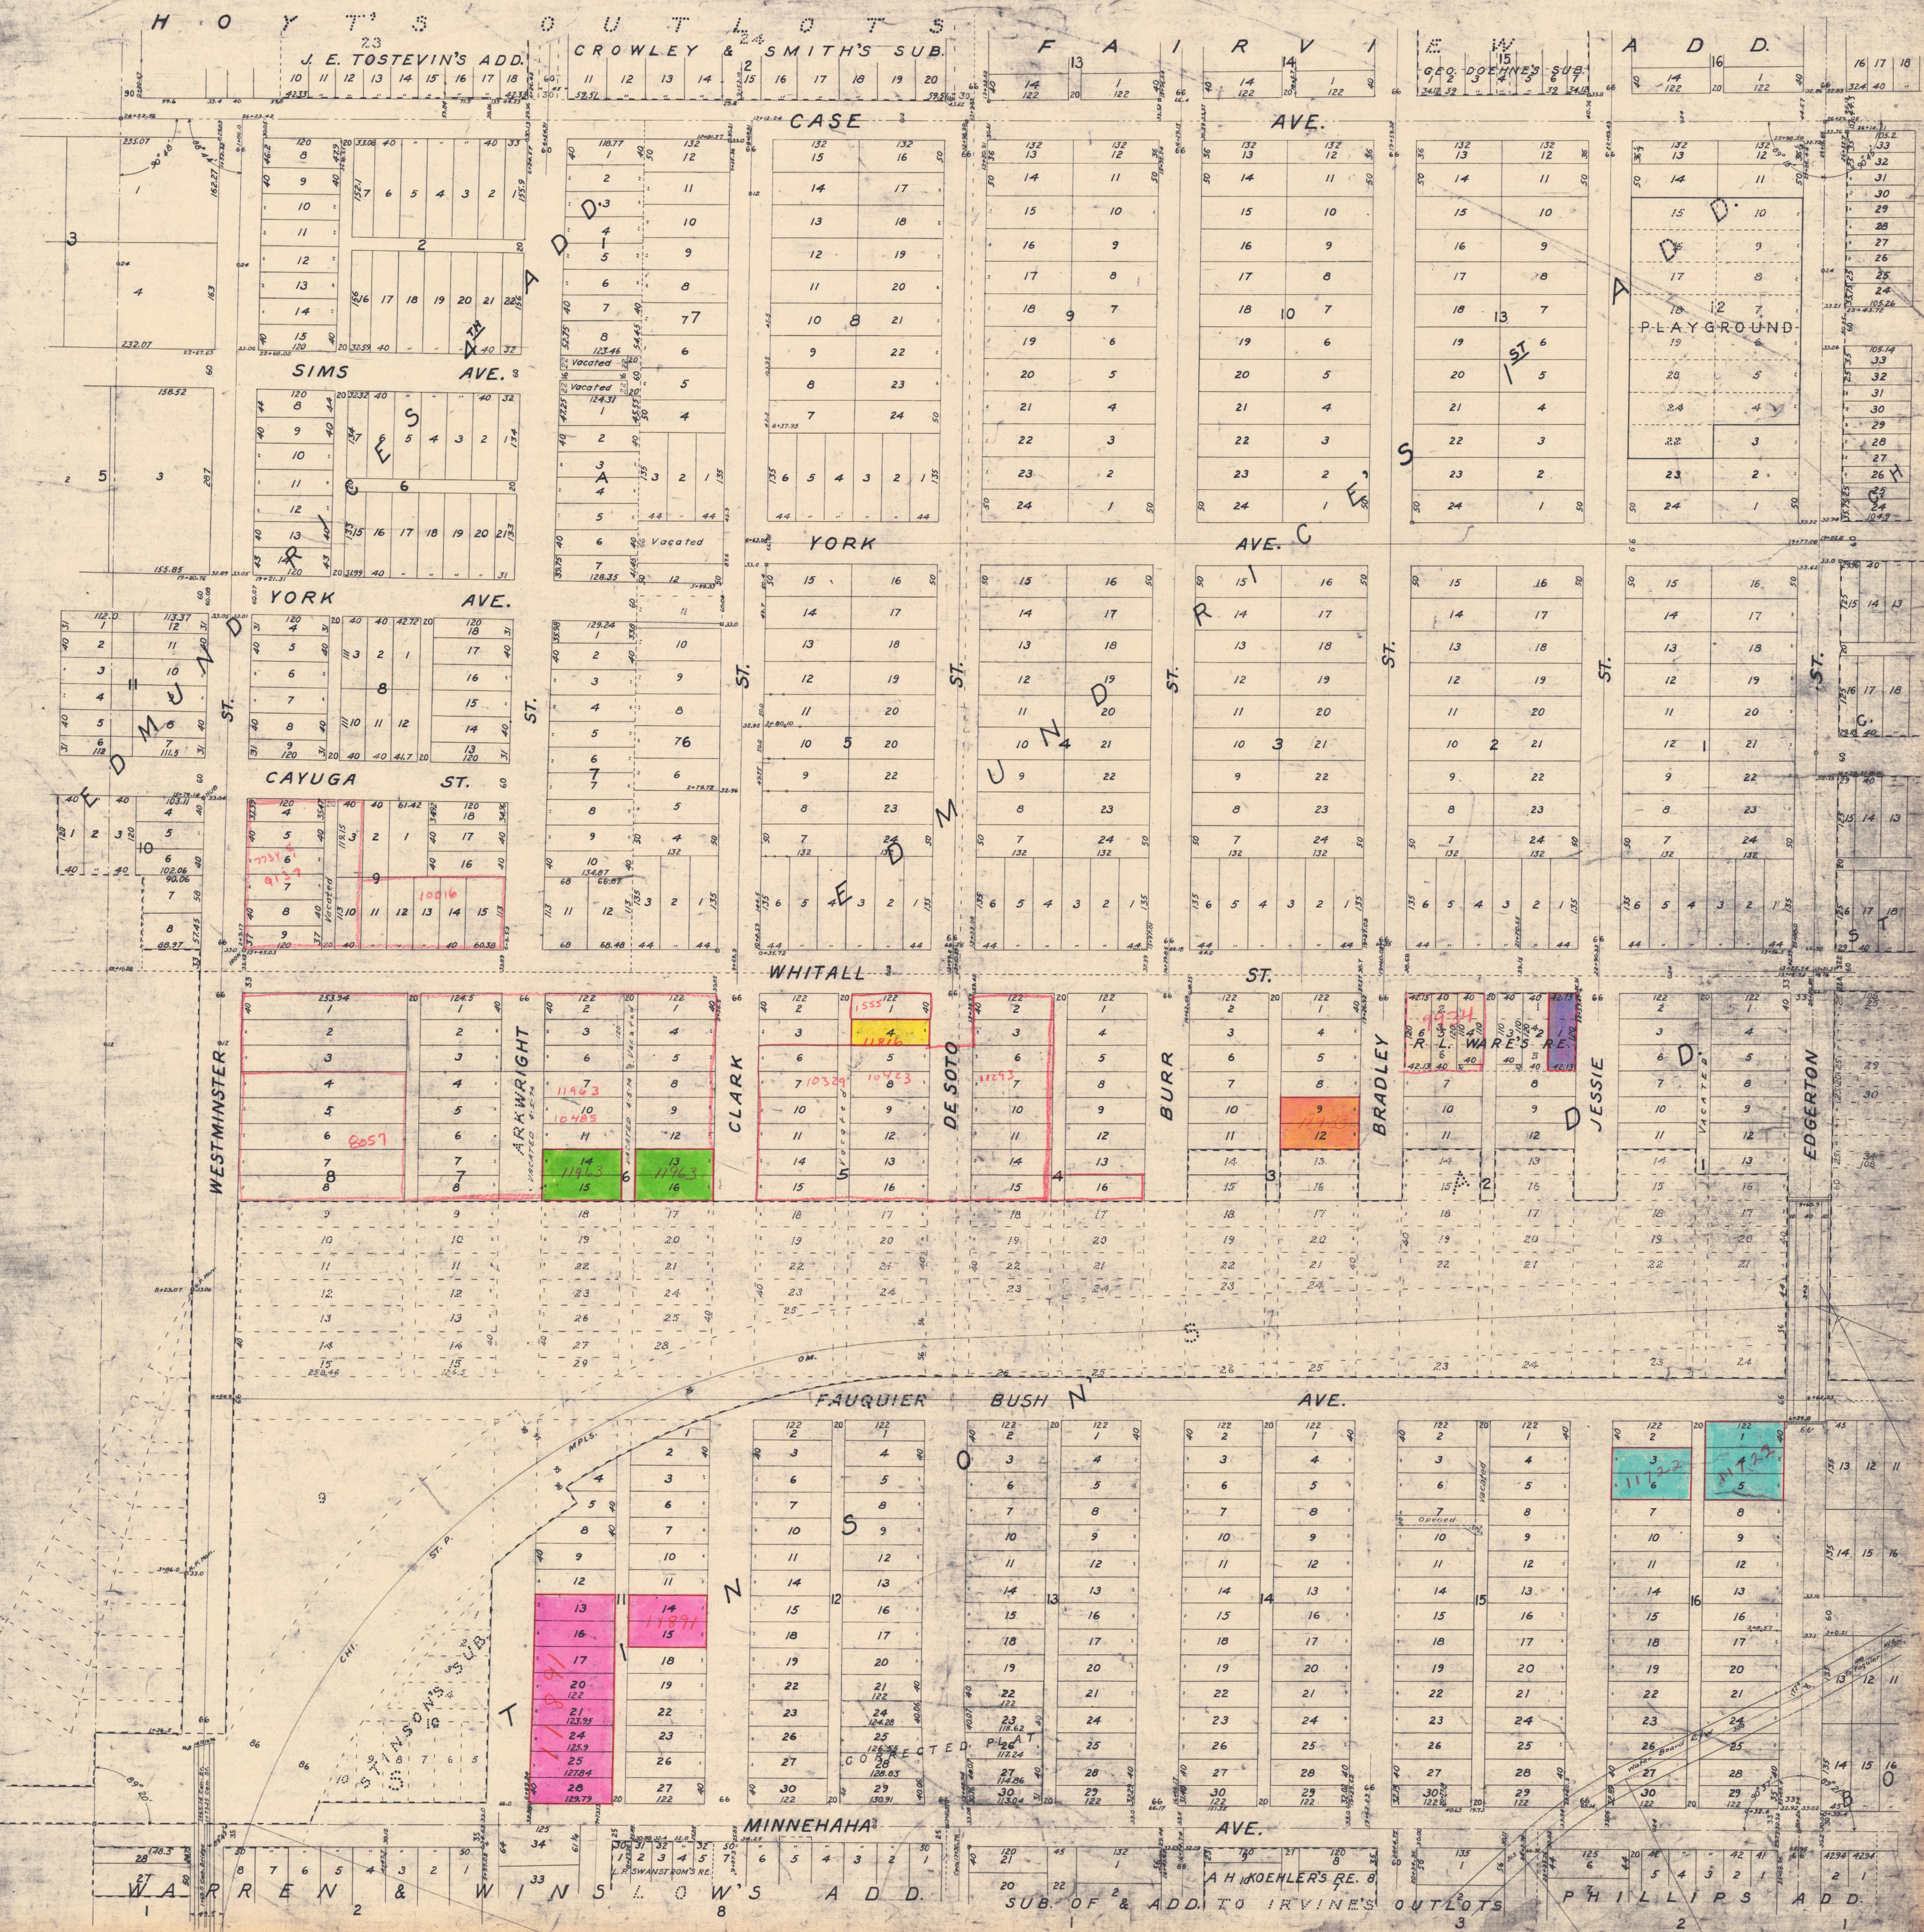

SW 1/4 29-29-22