


S. W. 1/4 Sec. 7—28-22

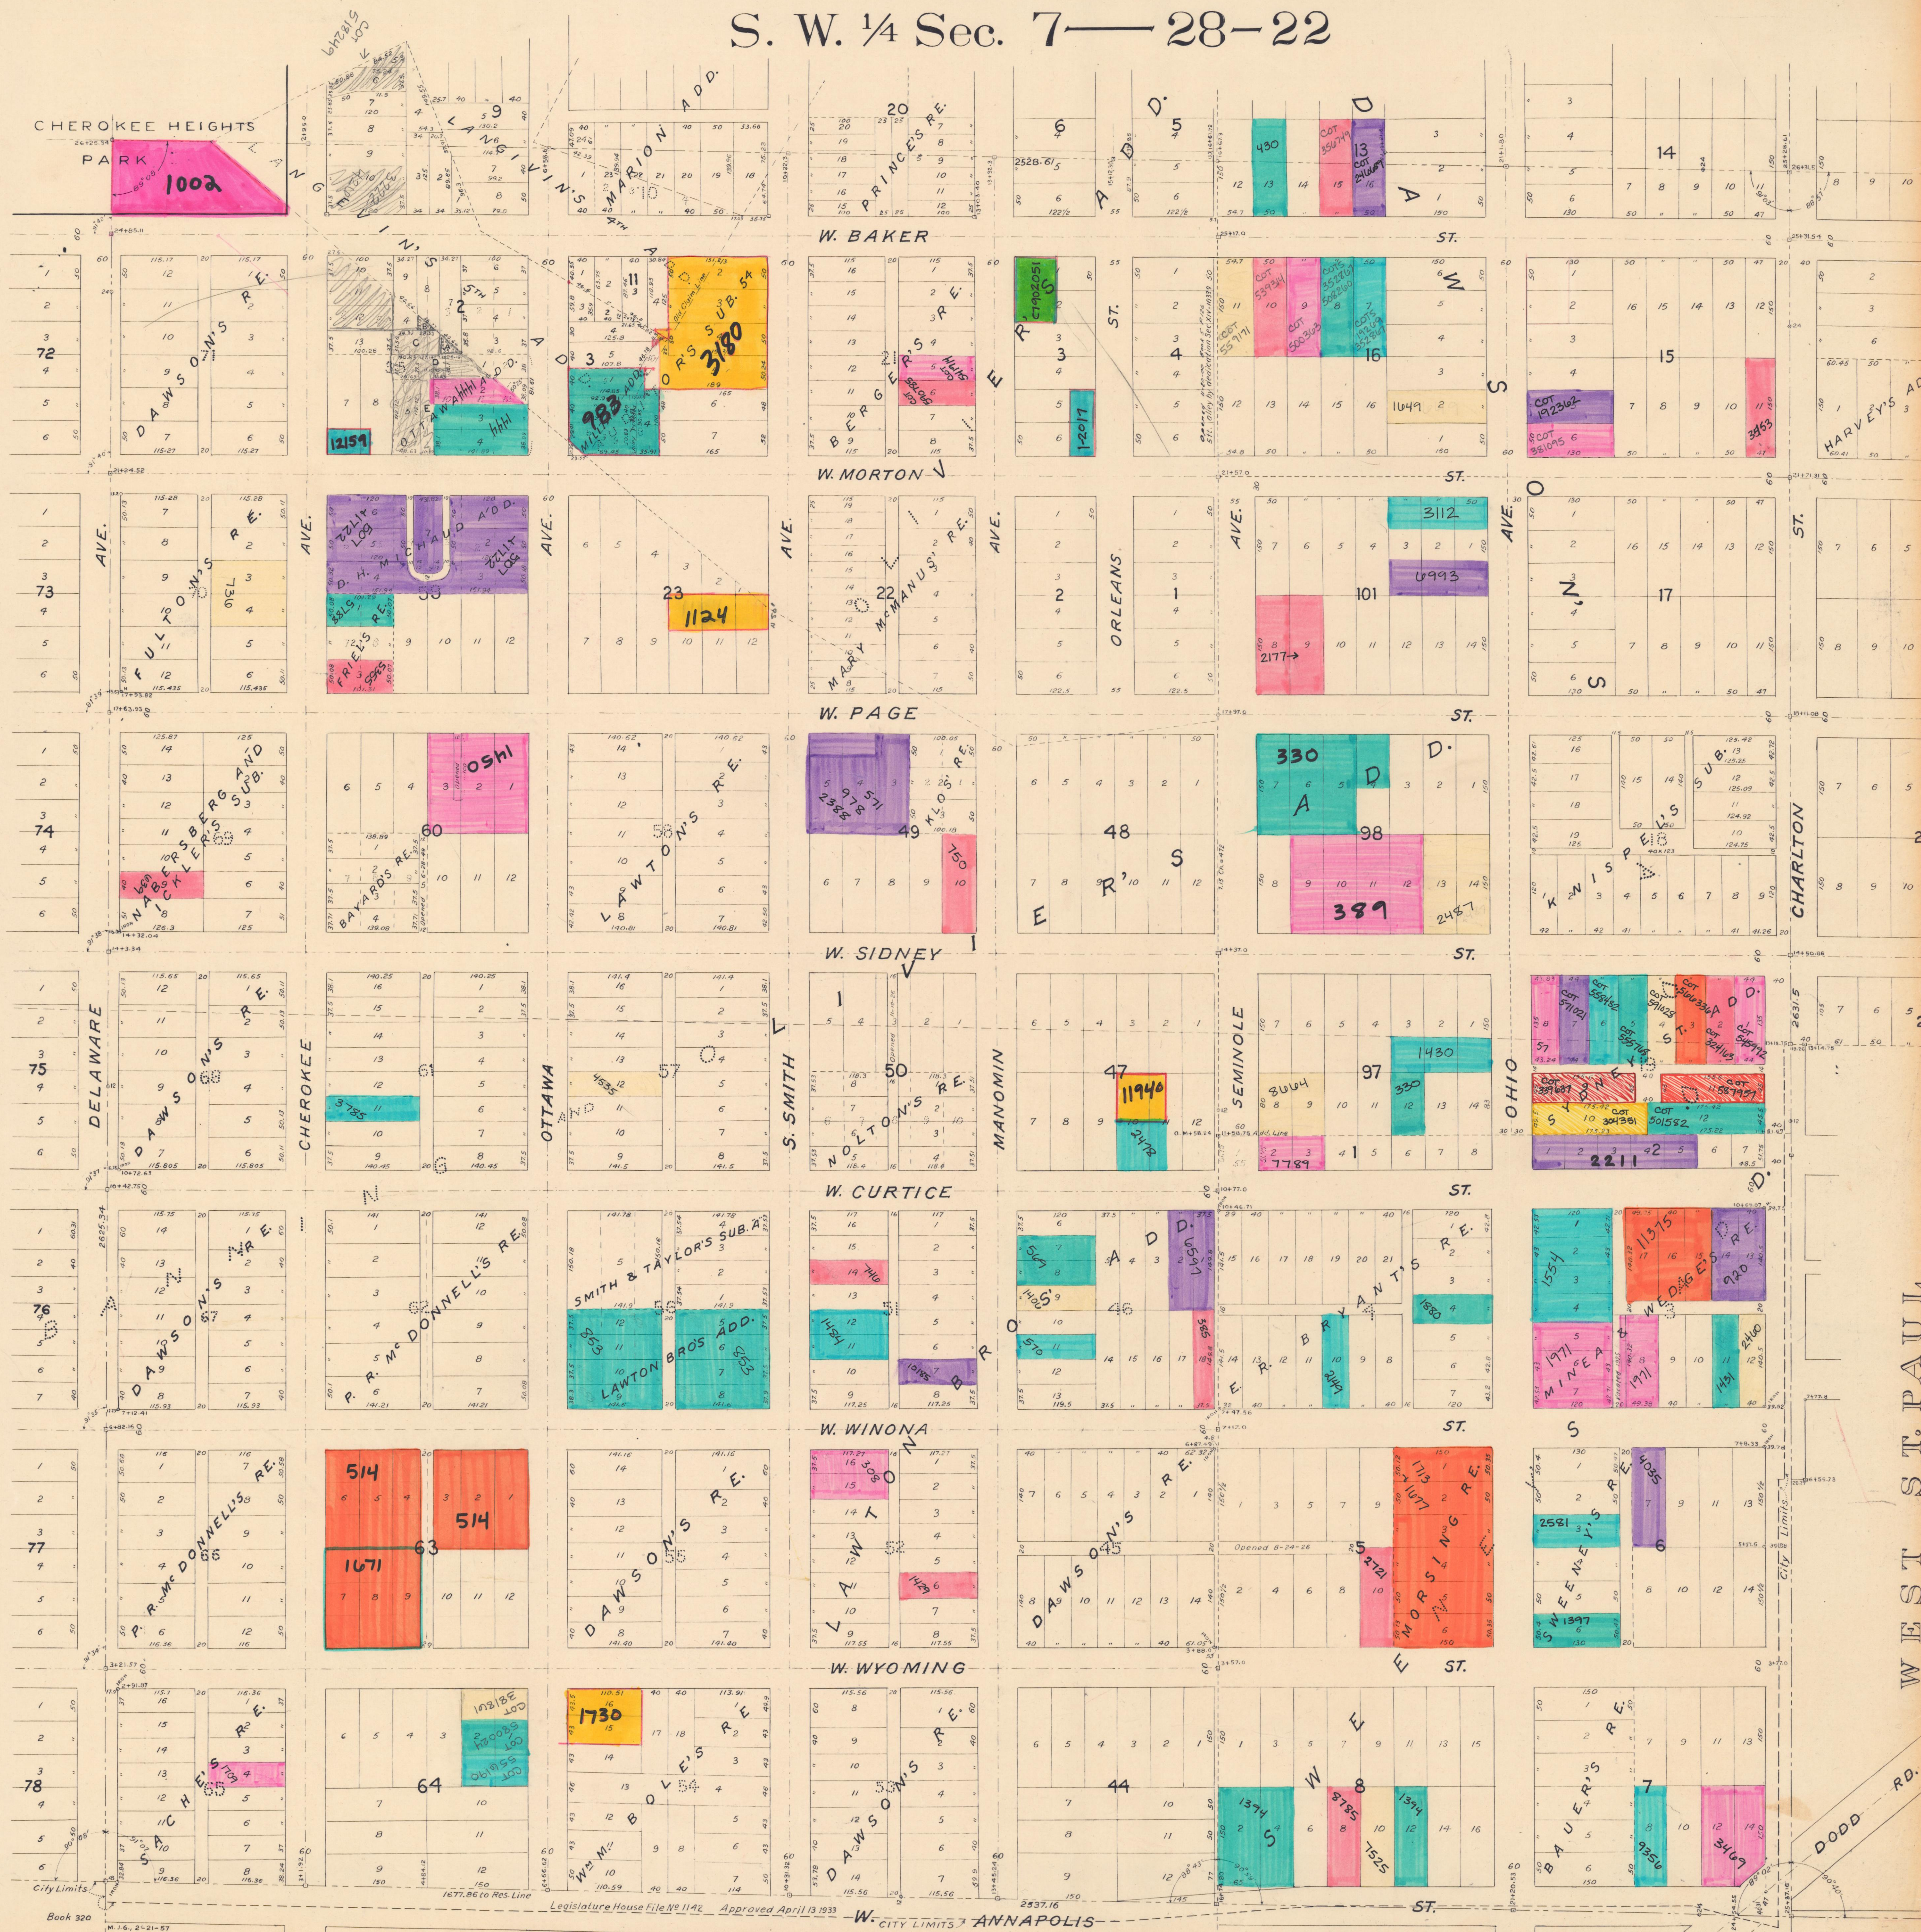

18-21

SW 1/4 7-28-22

N S

Book 320 M.L.G. 2-21-57

Legislature House File No 1142 Approved April 13 1933

W. CITY LIMITS ANNAPOLIS

WEST ST. PAUL

DODD RD.