

OFFICE OF COUNTY ENGINEER
RAMSEY COUNTY

REQUEST FOR SURVEY

Name L. L. SullwoldDate 10-27-27Address 311 Hamm Bldg.

Phone _____

Survey to cover

Lot _____
Block _____
Sullwold's Sub-Division & Estimate of
Earth Excavation

Addition to

Remarks:

Paid Jan. 15-28
\$55.00

Date Desired _____

R. M. Coates.OFFICE OF
RAMSEY COUNTY ENGINEEROFFICE OF
RAMSEY COUNTY ENGINEER

Drainage Project W.T. Lemon & Defiel
Land in Sec. 2-28-22 Ditch Lines 1-9

^{8 North}
East Line Phalen Park from Larbentaur Ave.
to 250 ft. Strip owned By City, Also 250 ft. Strip
from North Line Phalen Ph. to E. & W. $\frac{1}{2}$ Sec. 16

T. 29 R. 22 (Survey) 10-11

County Property Lines in the North West

$\frac{1}{4}$ of Sec. 16 T. 29 R. 22 12

County Property Lines in the South West

$\frac{1}{4}$ of Sec. 9 T. 29 R. 22 13

County Property Lines in the North West

$\frac{1}{4}$ Sec. 9 T. 29 R. 22 14

East County Line Location of Road in

Wash. County East of Silver Lake 15

Lake Ave. (White Bear) Stewart to Twelfth

Location of Orig. Corners 16


White Bear Blvd. (Simonton Blvd.)

East County Line to White Bear Road (Survey) 22-32

The S.E. $\frac{1}{4}$ of the S.W. $\frac{1}{4}$ Sec. 10, T. 30, R. 23


F. Scutta's 40 Acres 34


Lake Ave. (Bald Eagle) 37

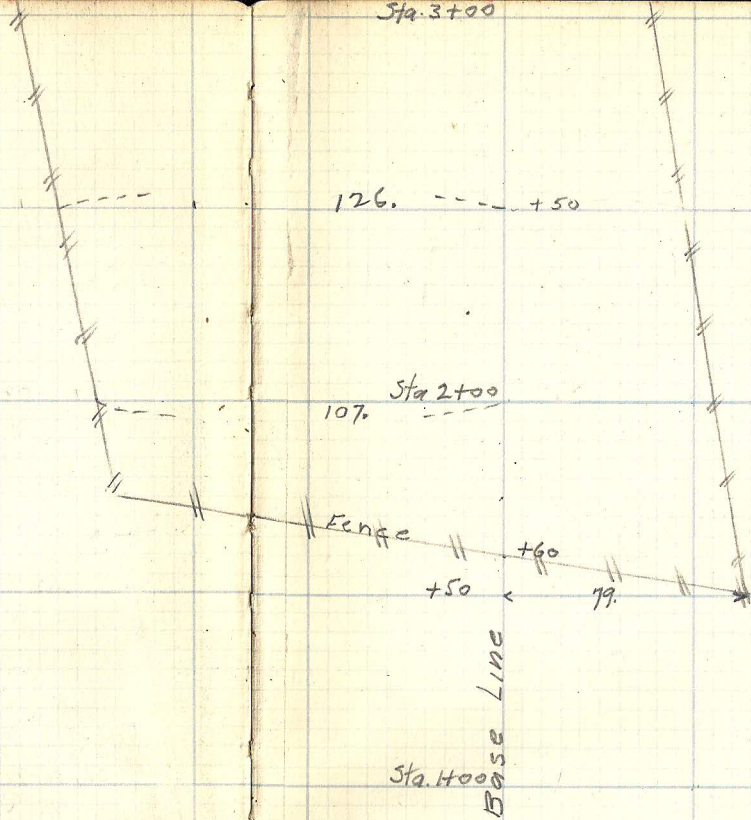



Level Notes
Book 82 P. 113


Alignment
Drainage Area
Book 82 P. 122
Oct. 1 - 23
R.H.


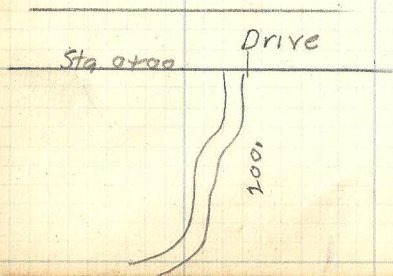


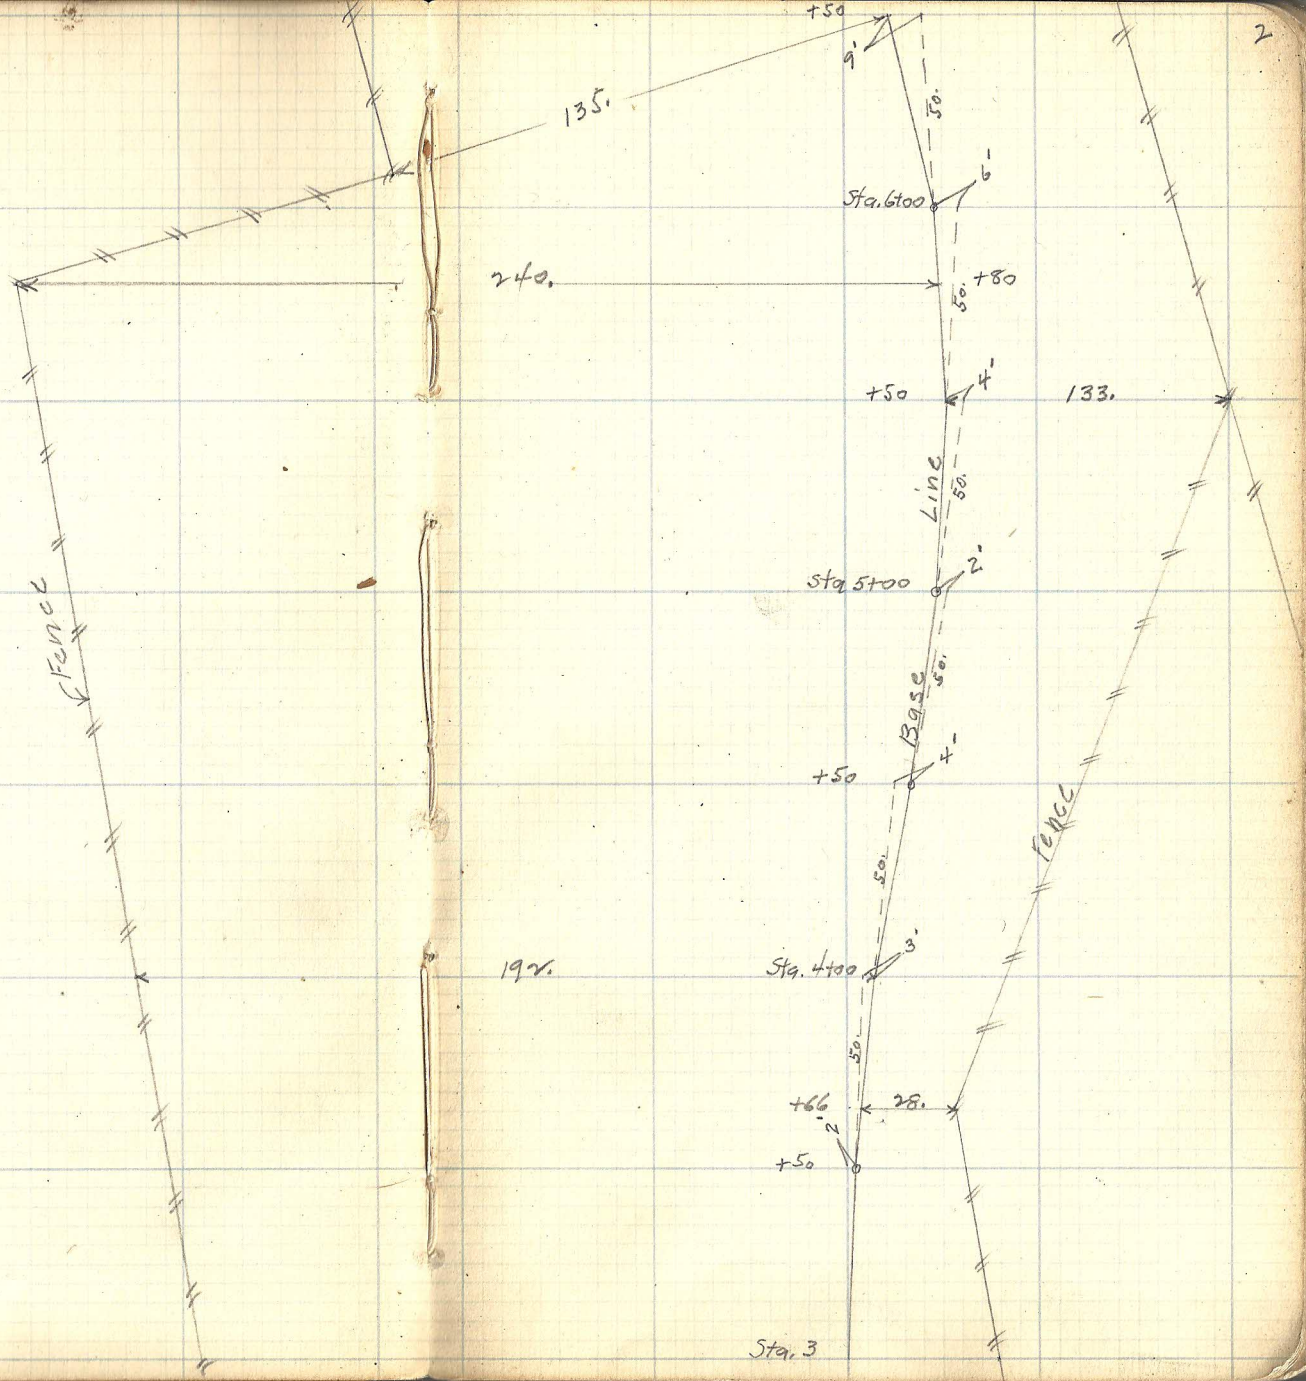


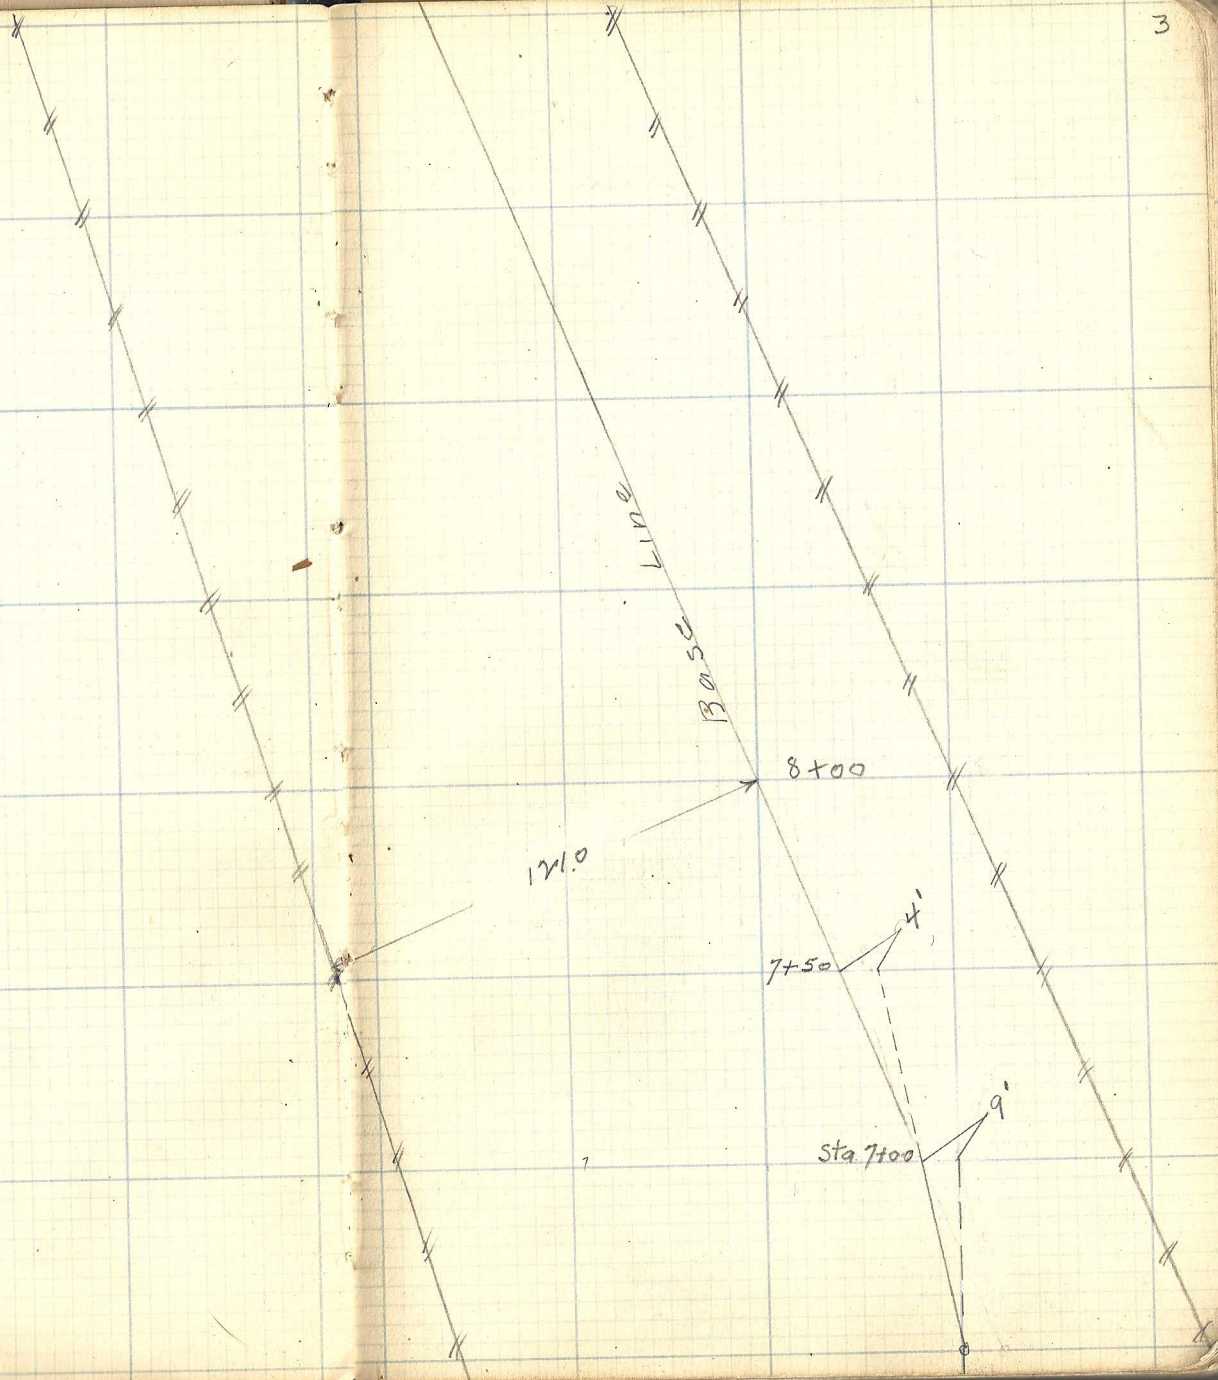

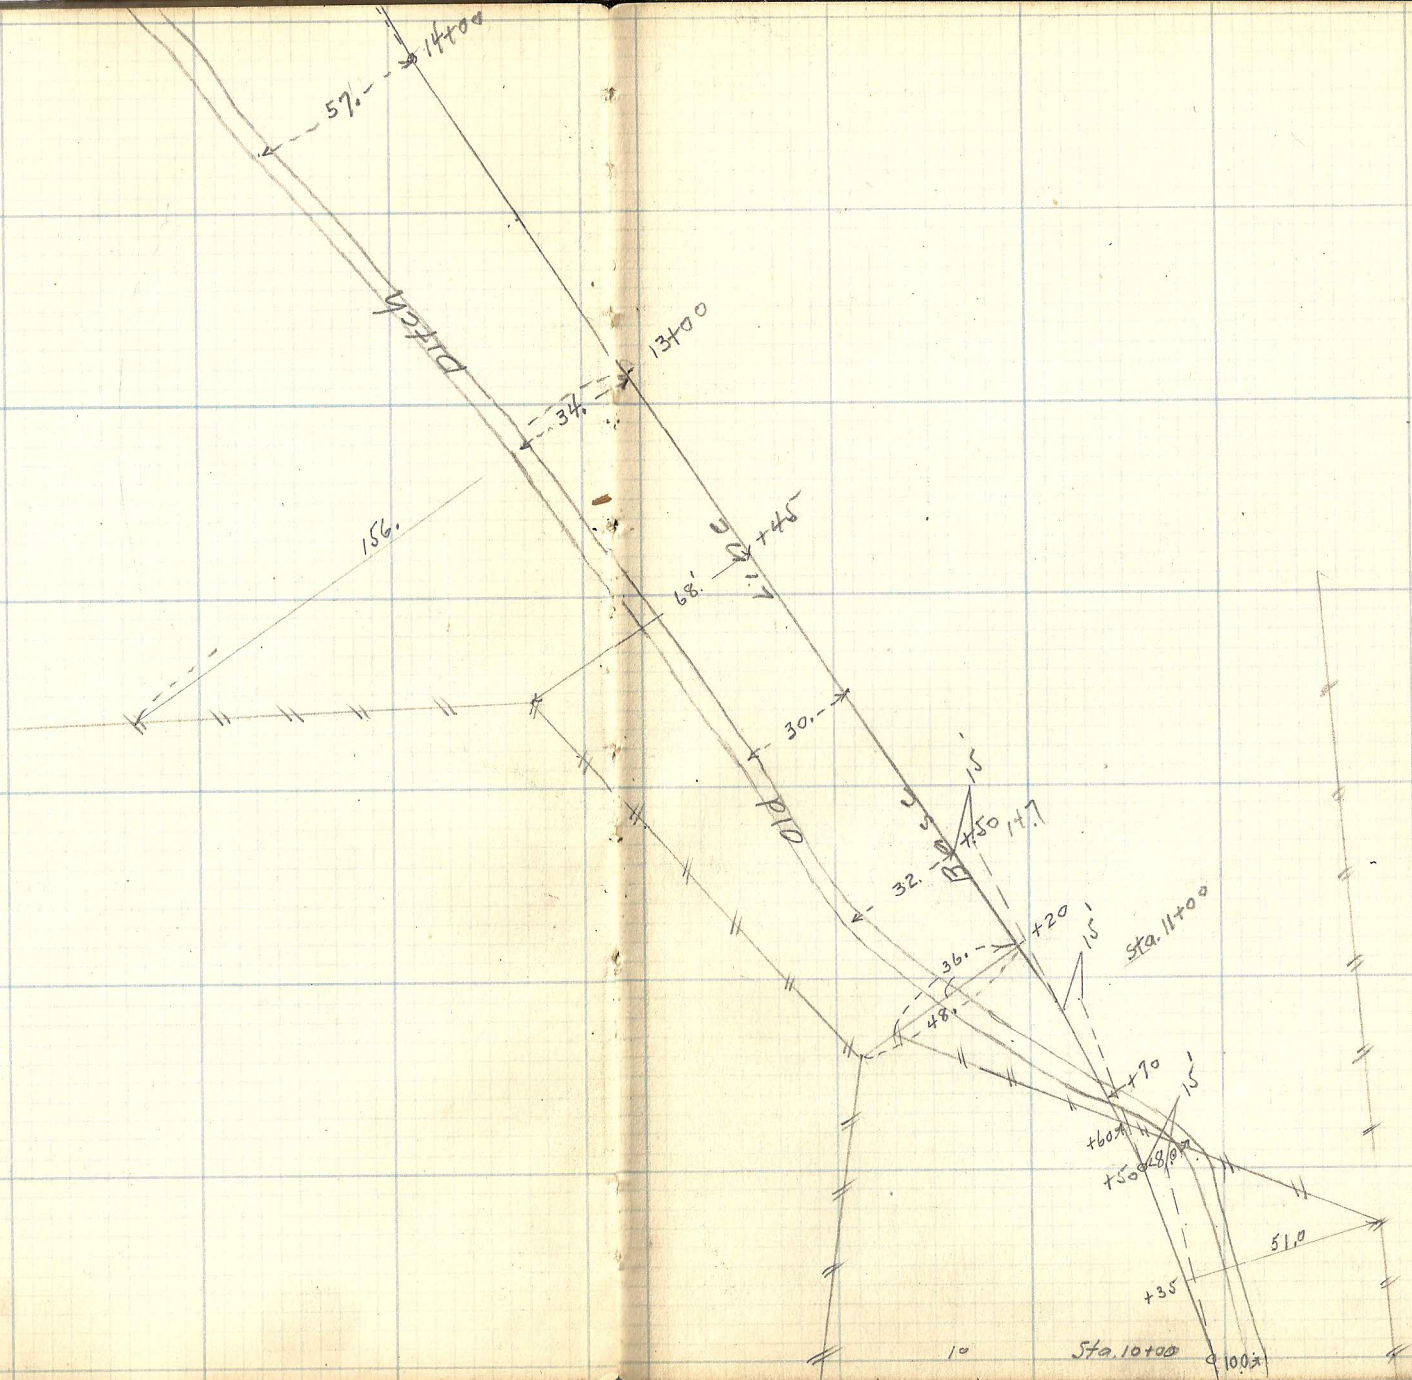

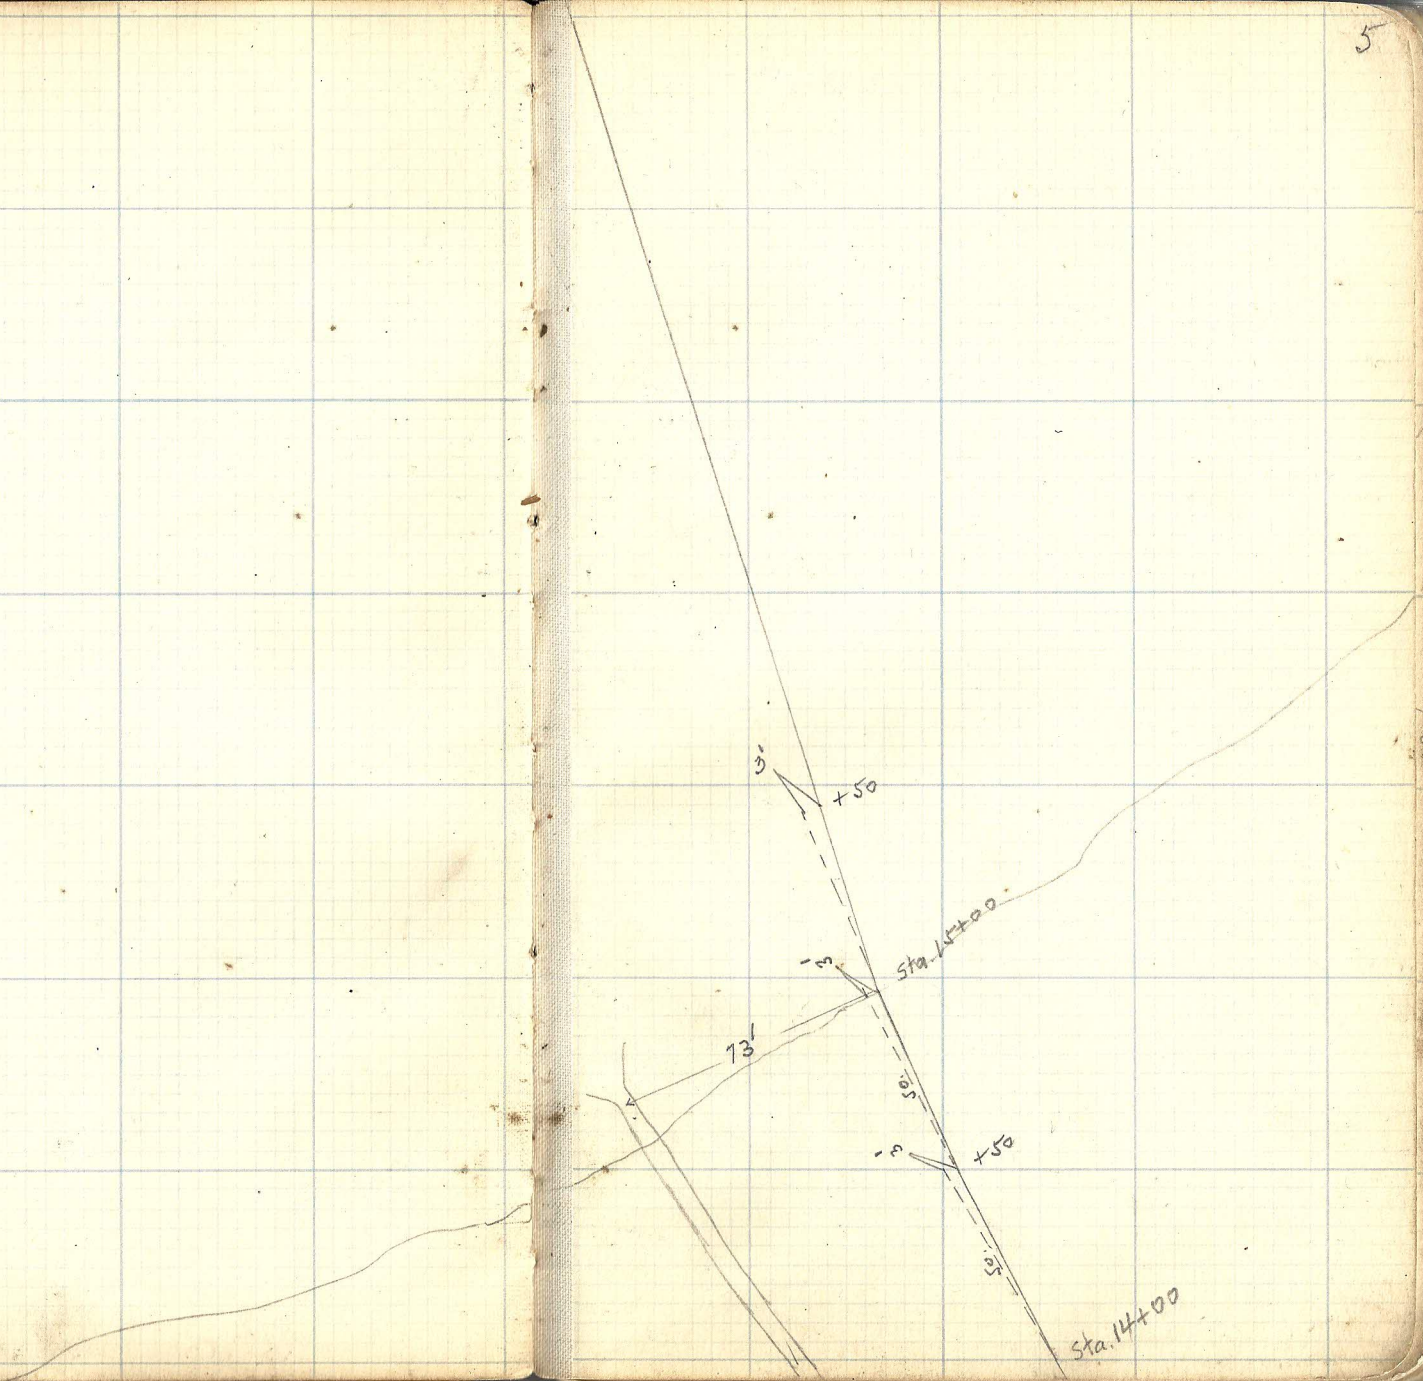

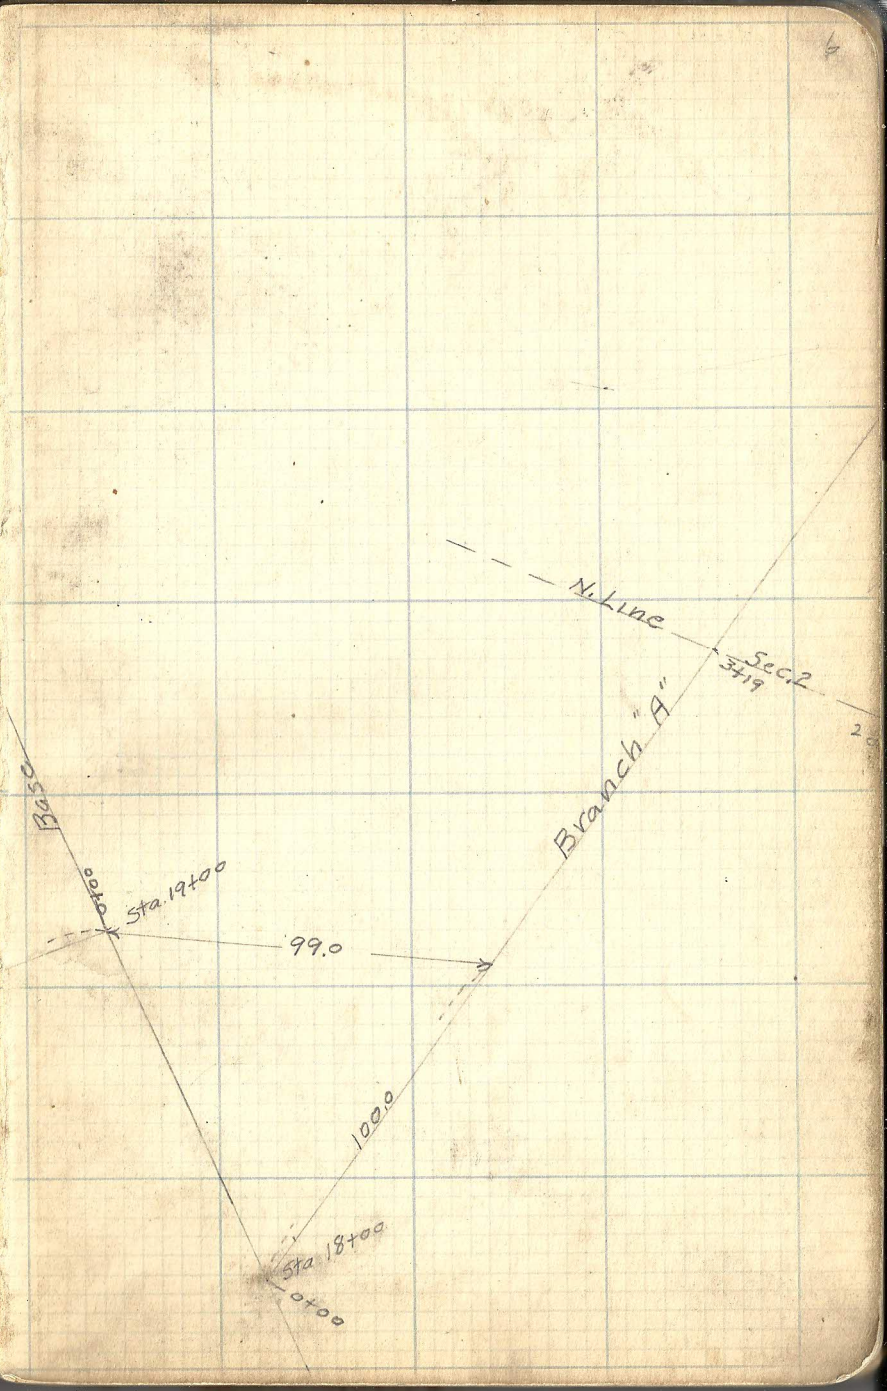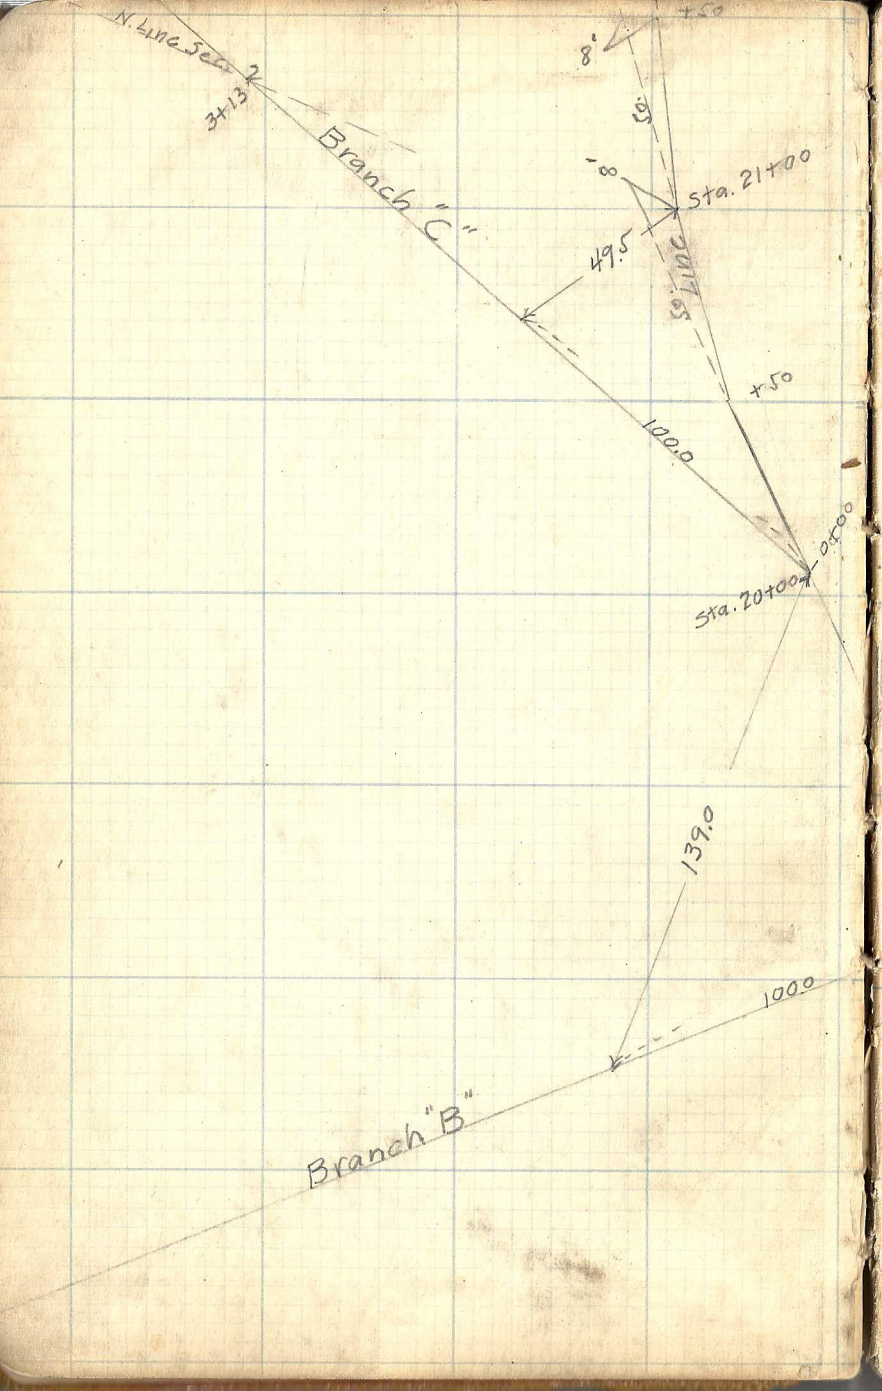

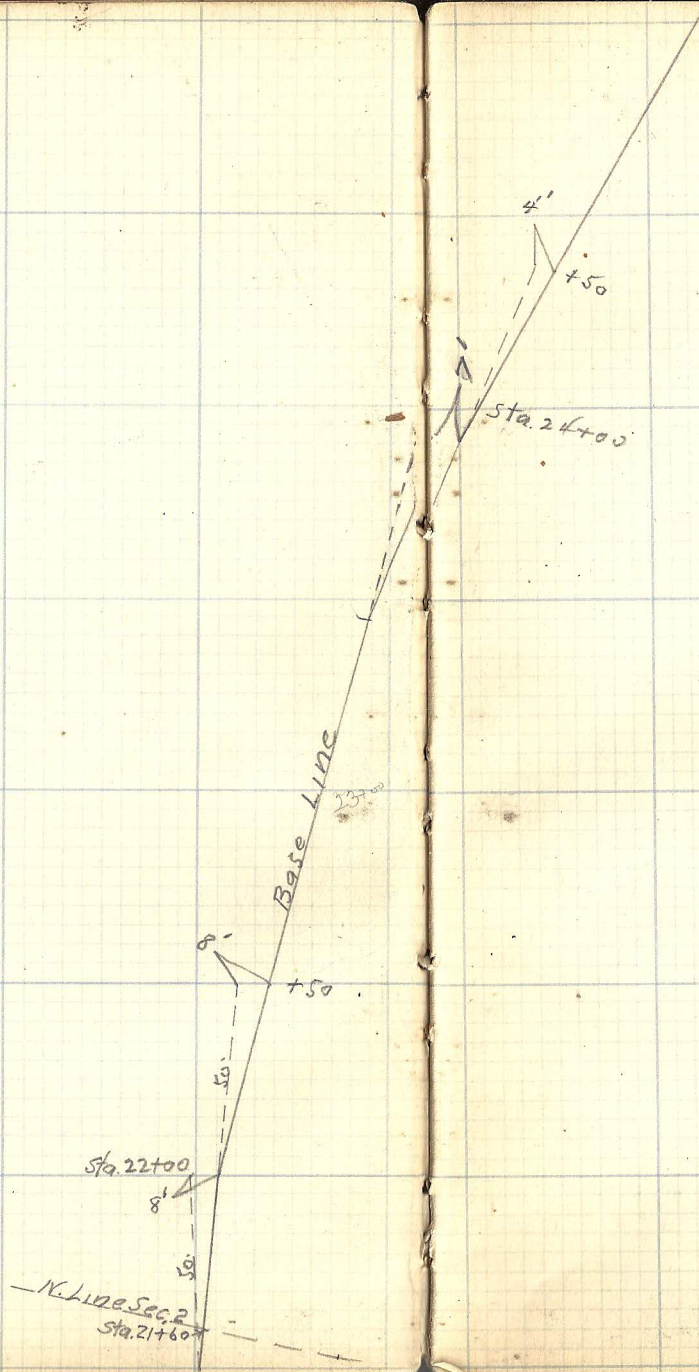

Base Line

Ditch


79+50 x 15.2

Base Line

Open




76+00

1120

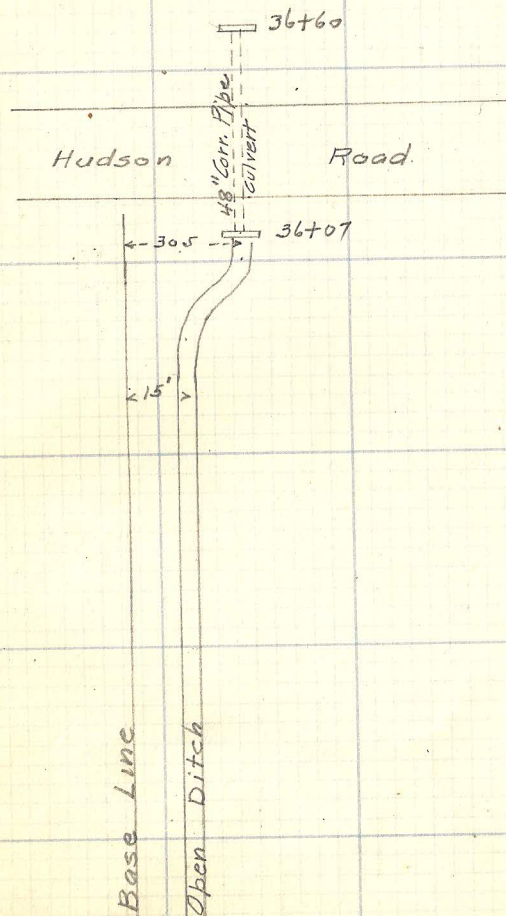

N.E. 1/4 Sec. 16


1268.25
267.78

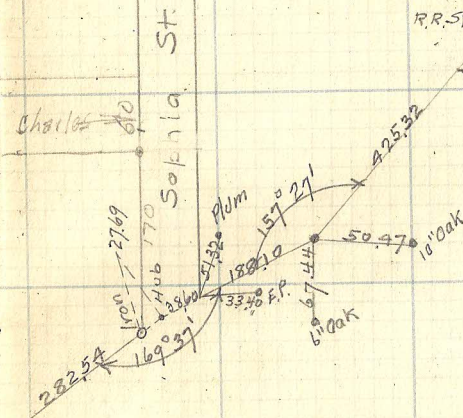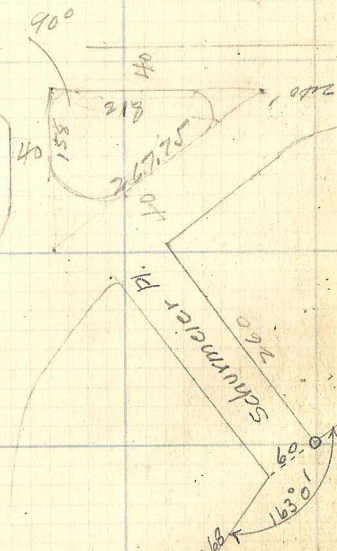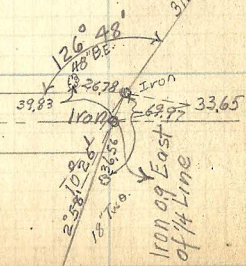

Dec. 1923
R.H.

East Line Sec. 16

✕

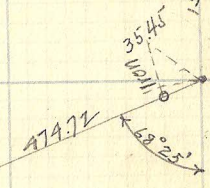


South Line Sec. 16 T. 29 R. 22

1552.82

S.E. Cor. Sec. 16
T. 29 R. 22

1699 24
1598 52
100,72

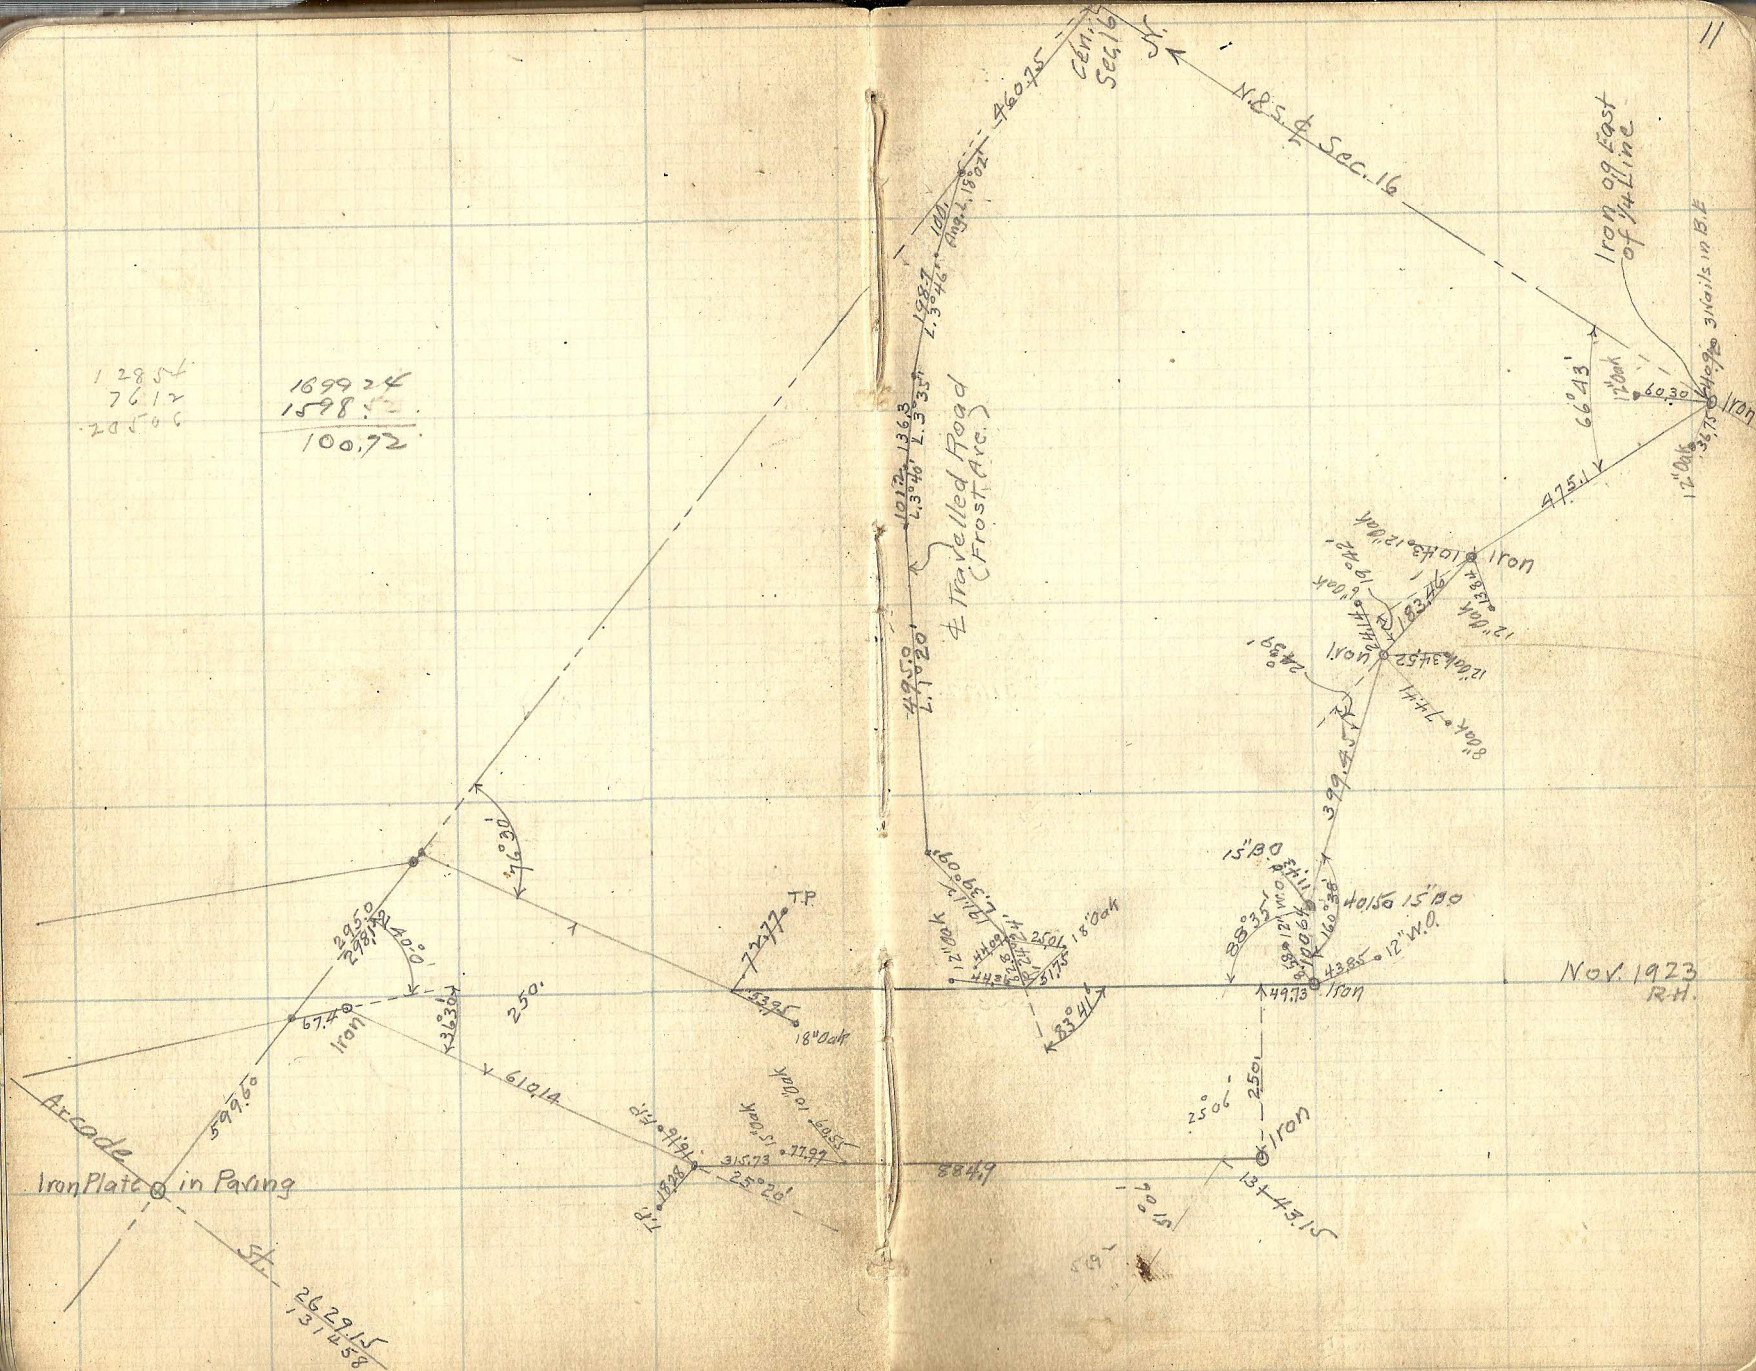


Scale = 1" = 400 ft.

2629.0

Cen. Sec. 16, 12


Nov. 1923
R.H.

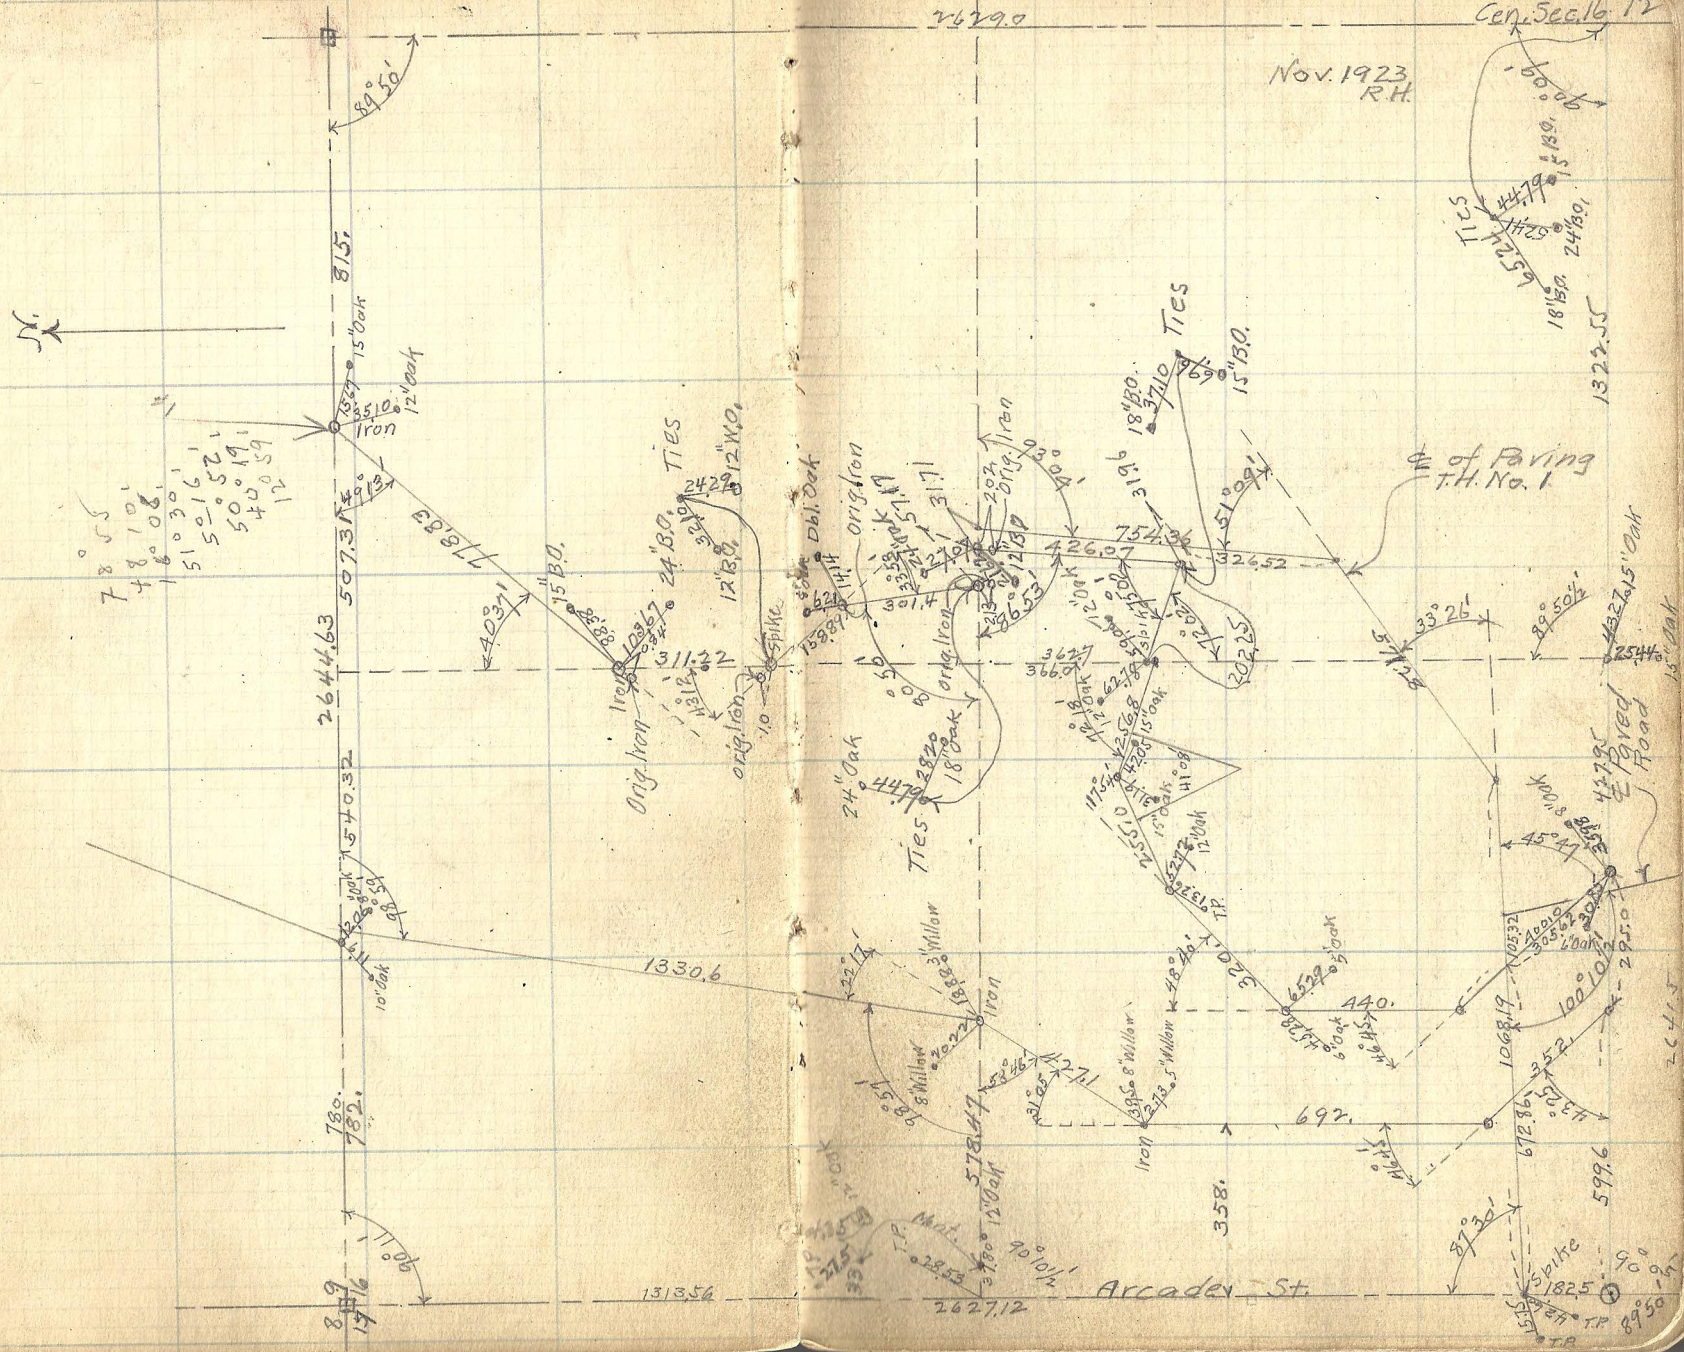

[illegible]


89 1716

Nov. 1923
R.H.

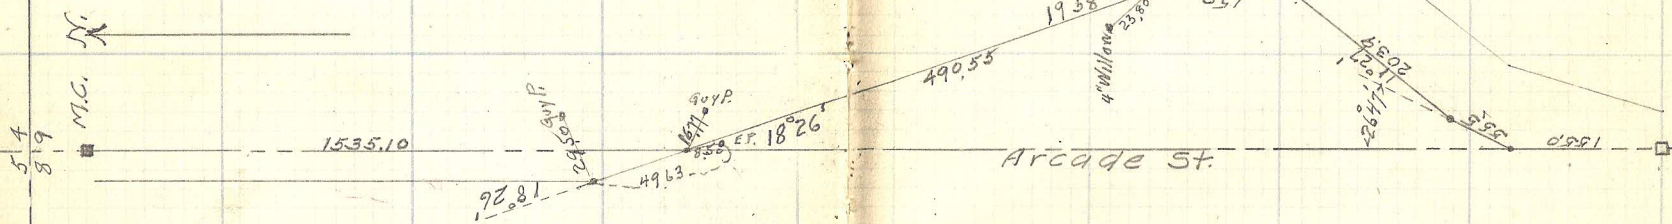


Location of $\frac{1}{2}$ of Road
in Washington County on
East Shore of Silver Lake
North St. Paul
(24 ft. Roadway)

Oct. 30-23
R.H.

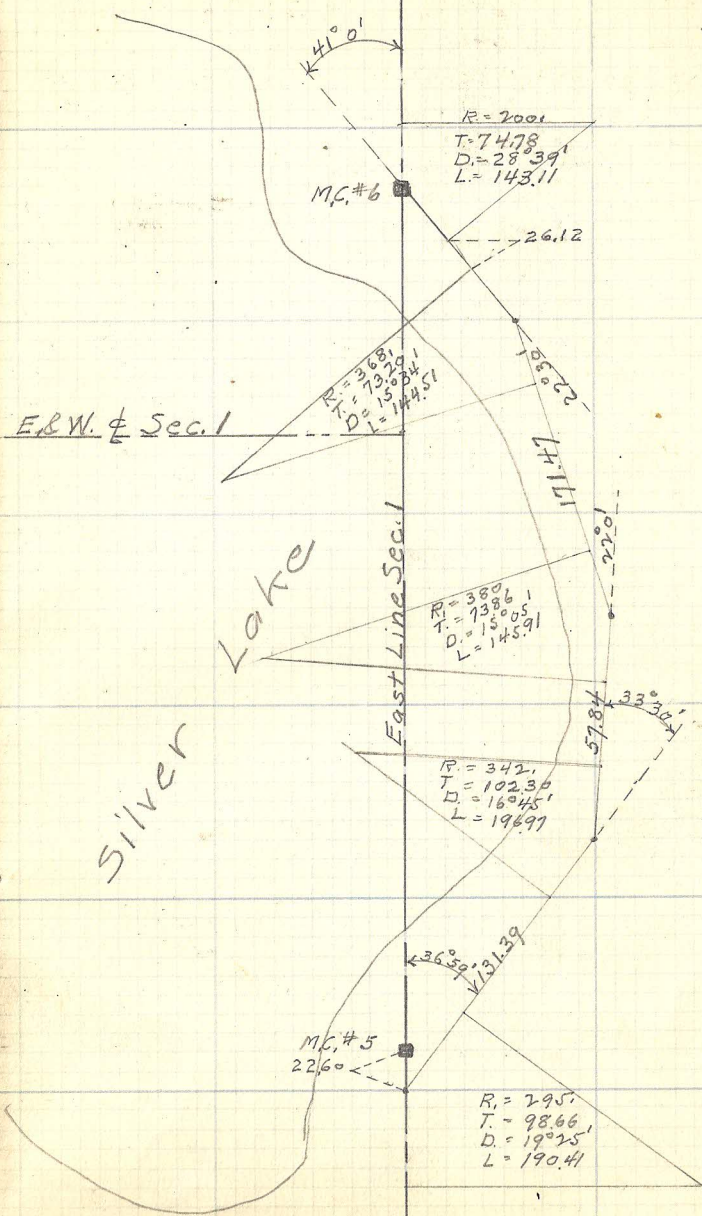


Johnson

St.

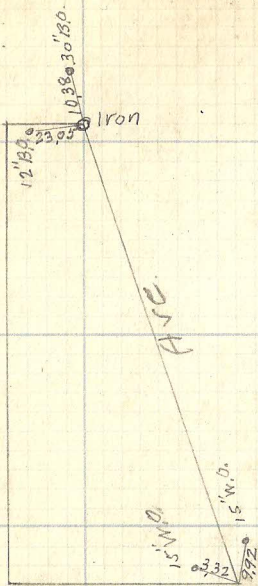


Morehead

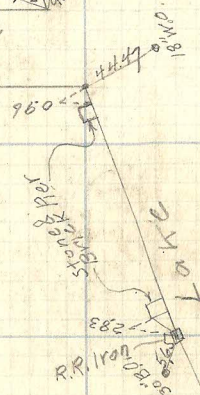


36" Cottonwood

Stewart

Lake Ave. (White Bear)

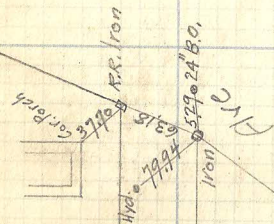


St.

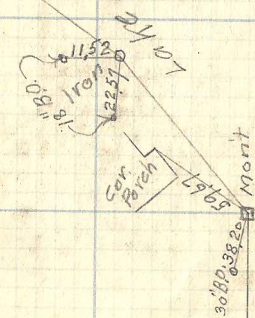

Johnson

Fifth

Fourth

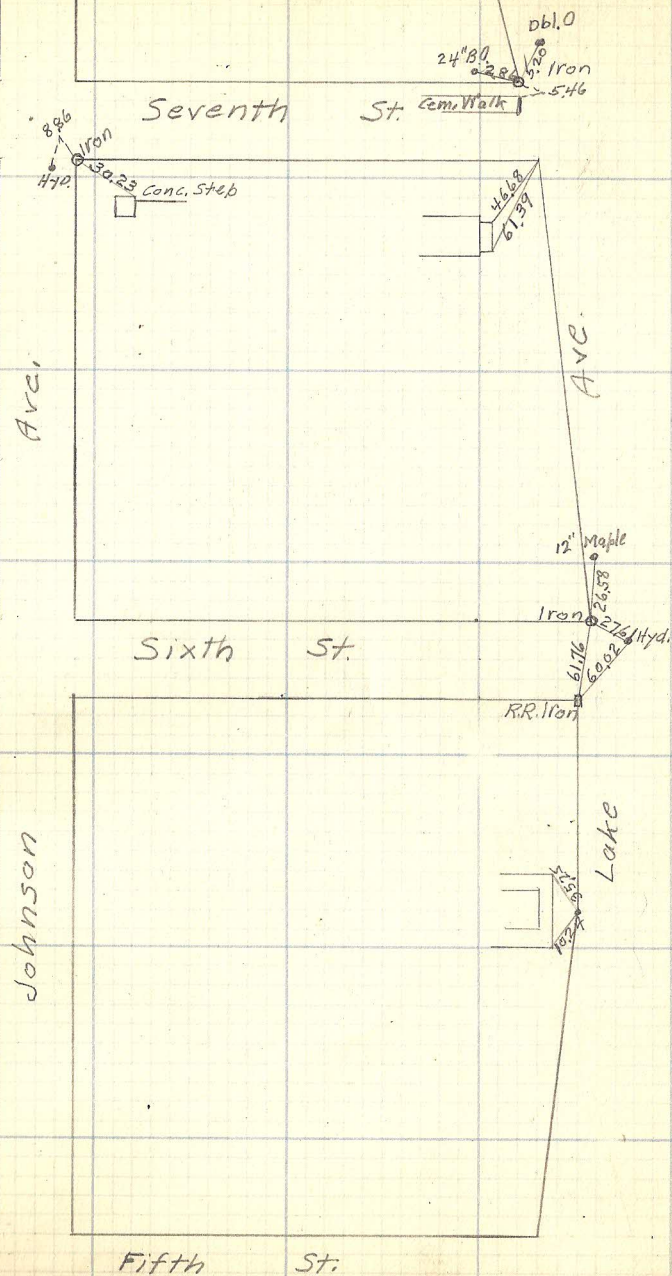

Porch Found:

15" 8.0. 11.38

69.44

Ave.

Morehead

Con. House

Can. Foundation

81.62

31.57 Iron

T.P. 760

128.46

Ave.

11.77 Hyd. 55.82 Iron

Ninth St.

Iron 75.98 87.69 Dbl. Oak

Ave.

Eeighth St.

15.69 15" Oak 89.20 T.P. Oak 28.39 Iron 45.34 15" W.O.

Lake

Seventh St.

Ave.

24" B.O.
3556
1726
7670
2177 • 24" B.O.

Morehead

Ave.

12.70
T.P.
Hyd.
Iron
5.21
T.P.

Johnson

Eleventh St.

Tenth St.

Ninth St.

12" B.O.
15" B.O.
18" B.O.
18" W.O.
3394
Iron

24" B.O.
1664 T.P.
34380 T.P.
Iron
50755
24" B.O.

Lake

Ave.

Morehead

Johnson

Twelfth

Eleventh

Ice House

Barn

St.


86.20


Iron

88.41

original & Simonton
 Blvd. (Bellairr Add.)
 Mch. 1924 B.H.

South Line Sec. 24-30-22
 2629.98 to South 1/4 Post Sec. 24
 (Cen. Bellairr Page 24)

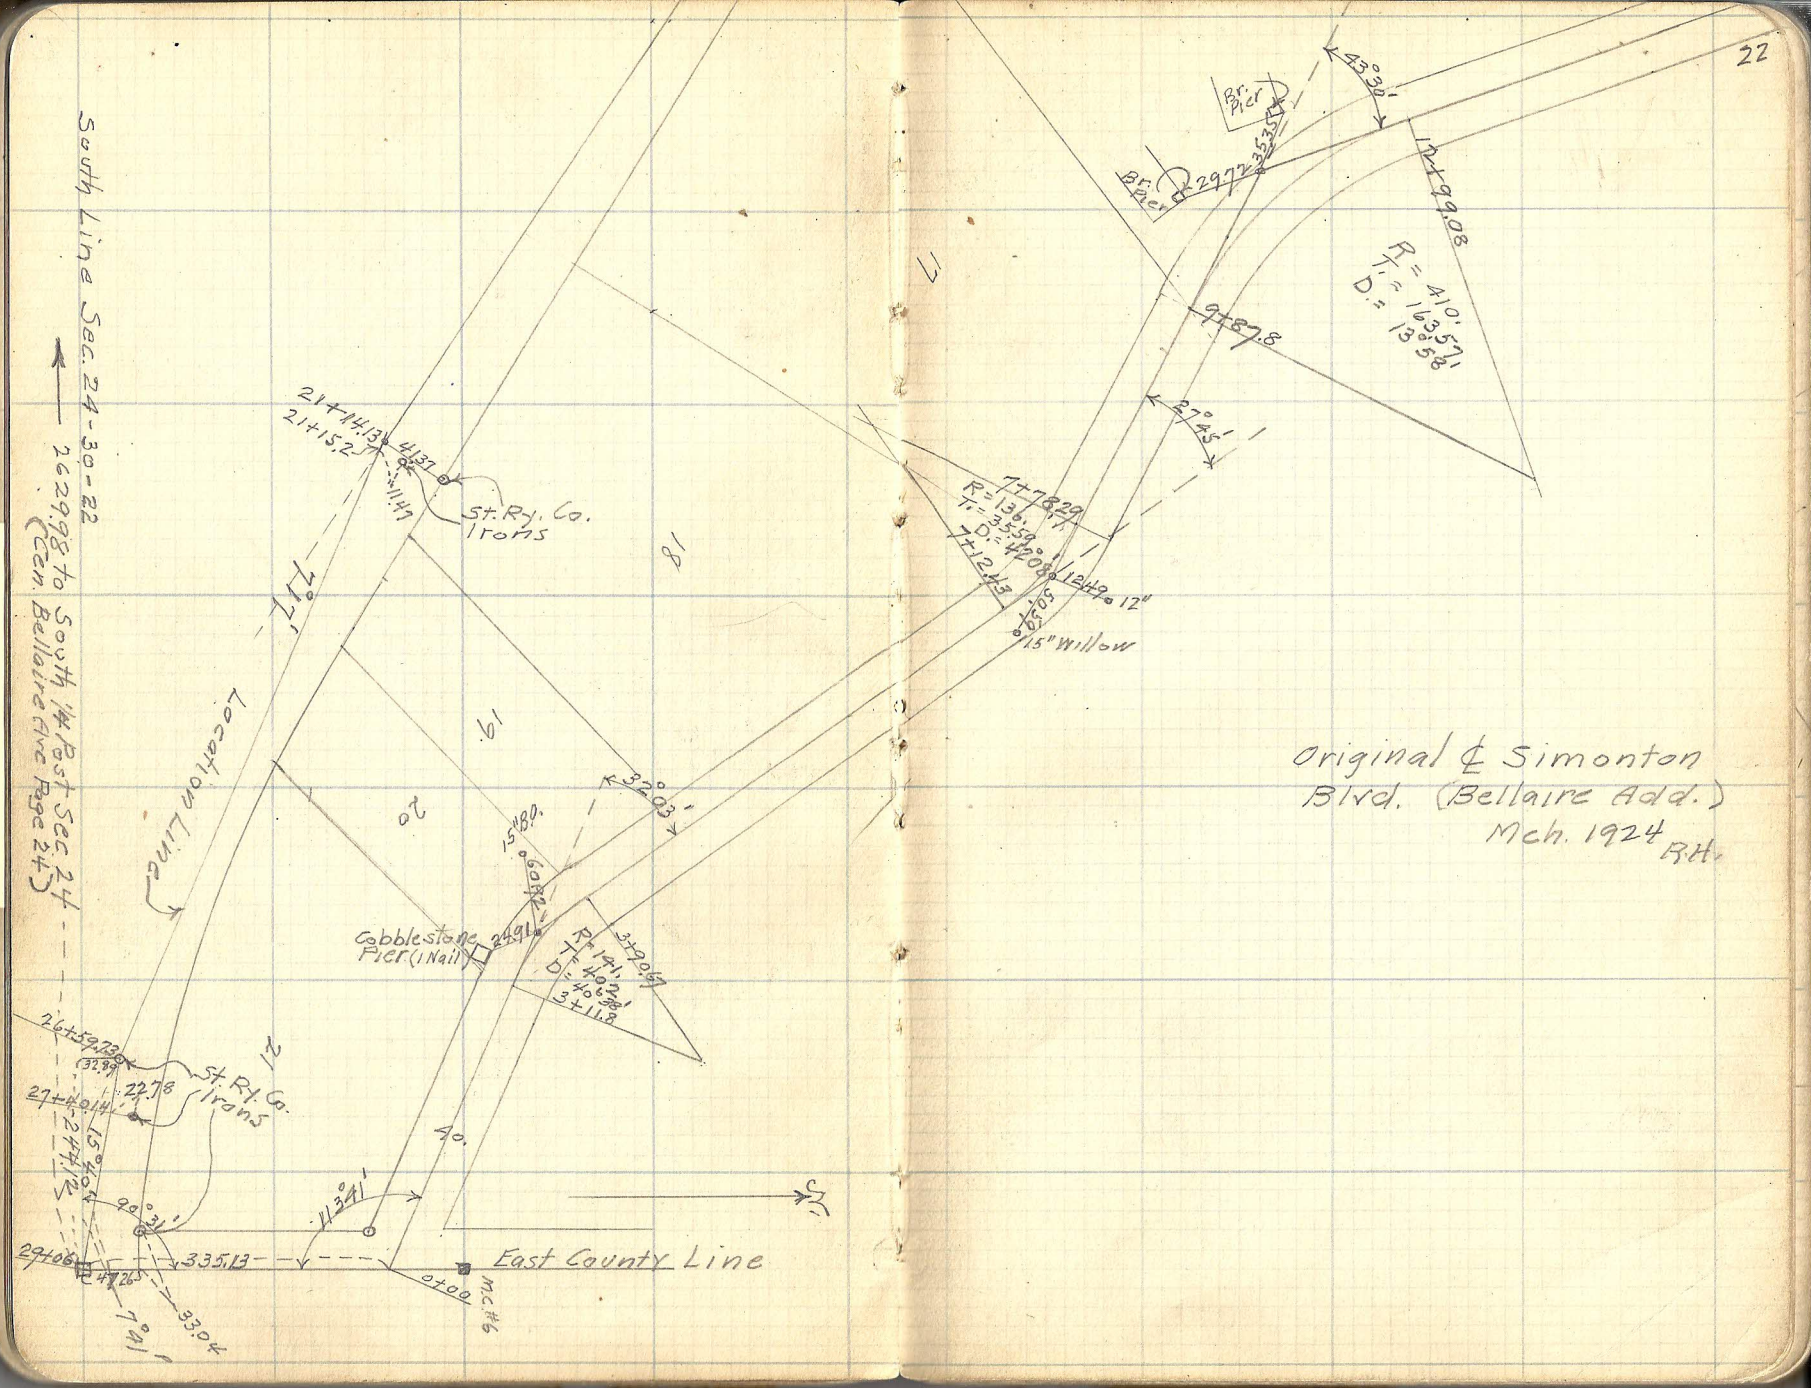

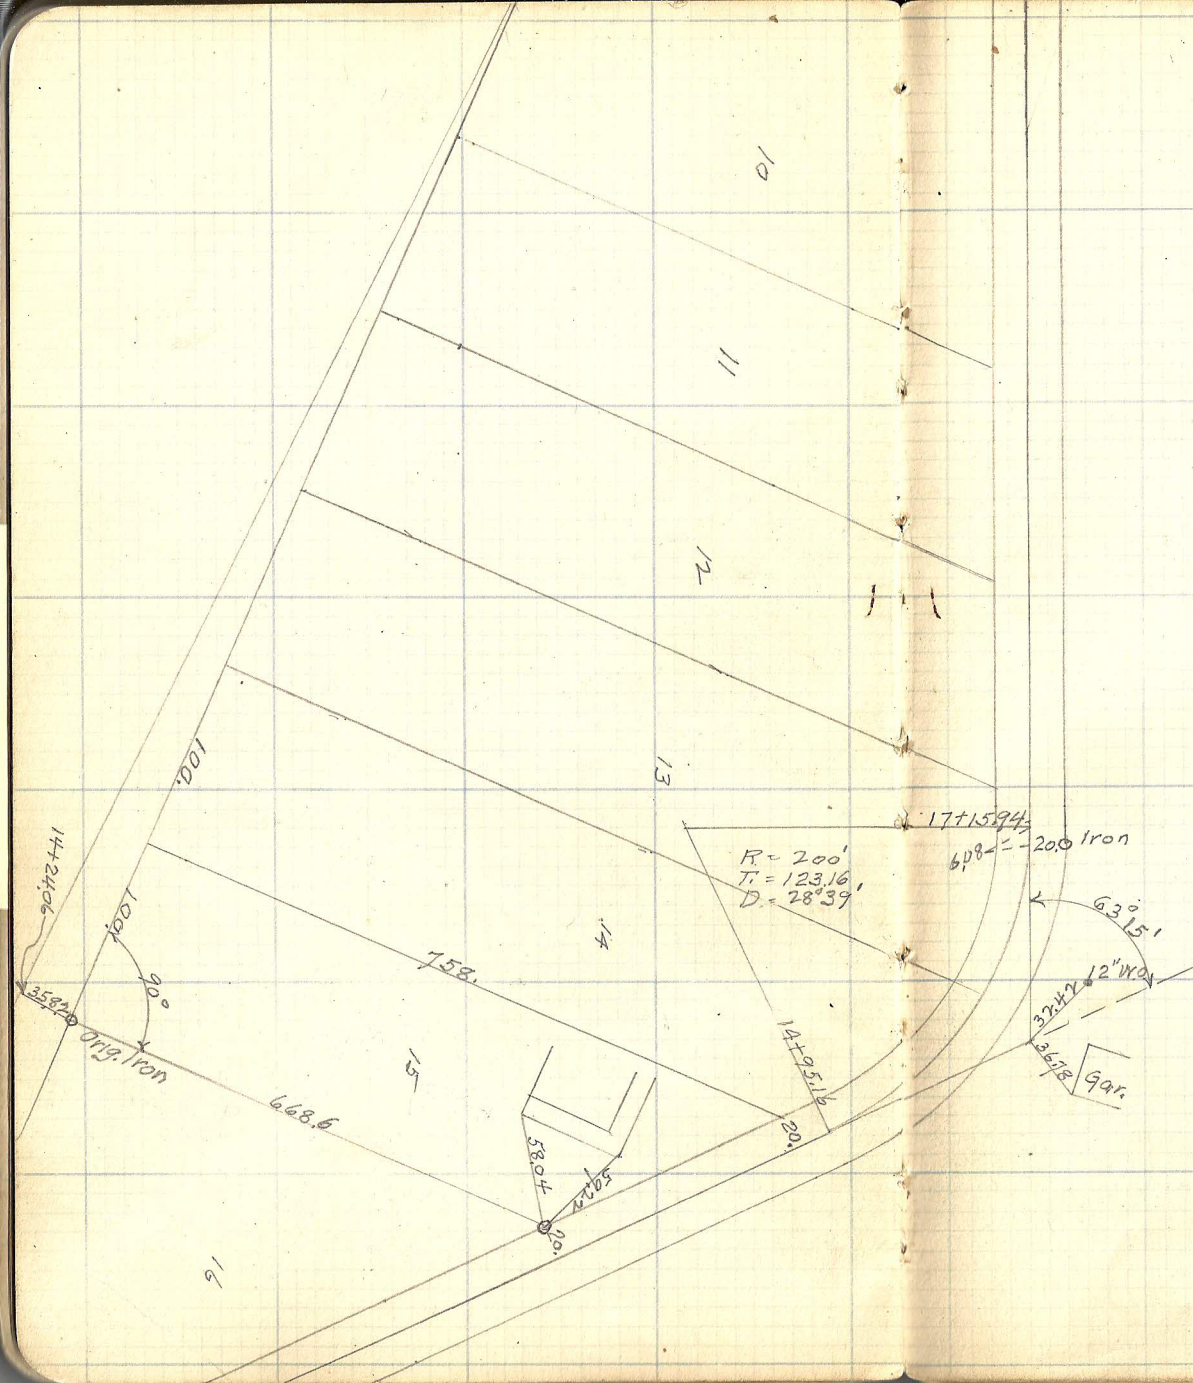

1/4 Line = 4 Bellaire Ave.
1157.45

1792.35

632.85

8" B.O.

66

99° 03'

12" B.O.

407.53
409.6

M.C. #

Orig. Hub

Orig. Hub

243.23

35.6

Location Line

5+20
22.7

5.65

Orig. Hub

30+36.79

R=368.

T=49.89

D=40.04

29+40.80

19° 03'

25+85.36

45.11 F.P.

38.75 F.P.

R=645.8
T=108.84
D=8° 52'

23+69.71

20' Iron

St. Clair Co.
Iron

39+05.62 ~~31.72~~ Iron
39+04.76 ~~35.45~~ Iron

43+98.27 33.81 Iron

43+76.89 33. Orig. Hub

40+96.09 33. Orig. Hub

40+35.44 33. Orig. Hub

$5=14$
 $T.P. 33.64$
 $48+29.80$
 21.73
 $T.P.$

$57^{\circ}04'$
 $15'' B.P.$
 23.27
 14.74
 $15'' W.O.$

$R. = 540.$
 $T. = 293.40$
 $Deq. = 10^{\circ}36'$

$51+2686$

60+04.92 ← 33. Iron

59+06.61 → 42°02'

30.87 15" B.O.


49.72 8" B.O.

$R = 156.03$


$T = 60.0$

$D = 36^{\circ}43'$


57+92.16

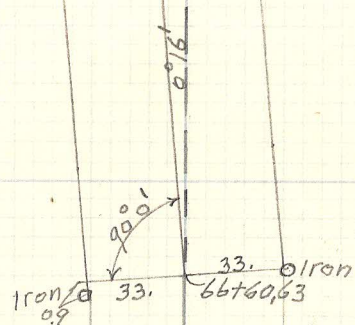

$69+24.48$ $33.$ Iron

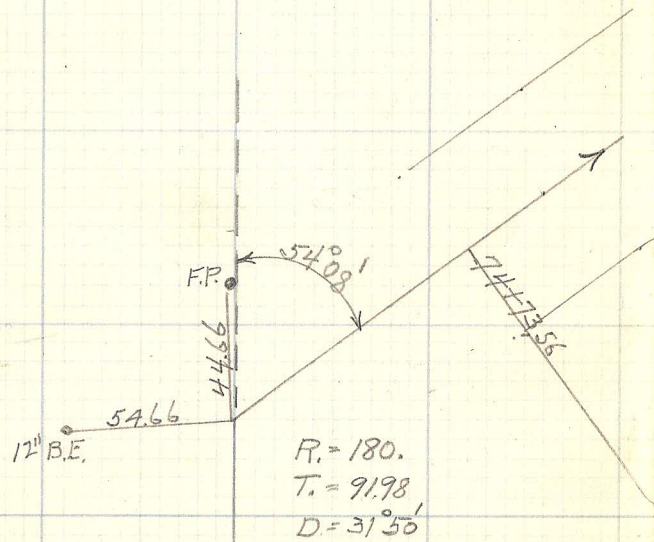

73+03.50

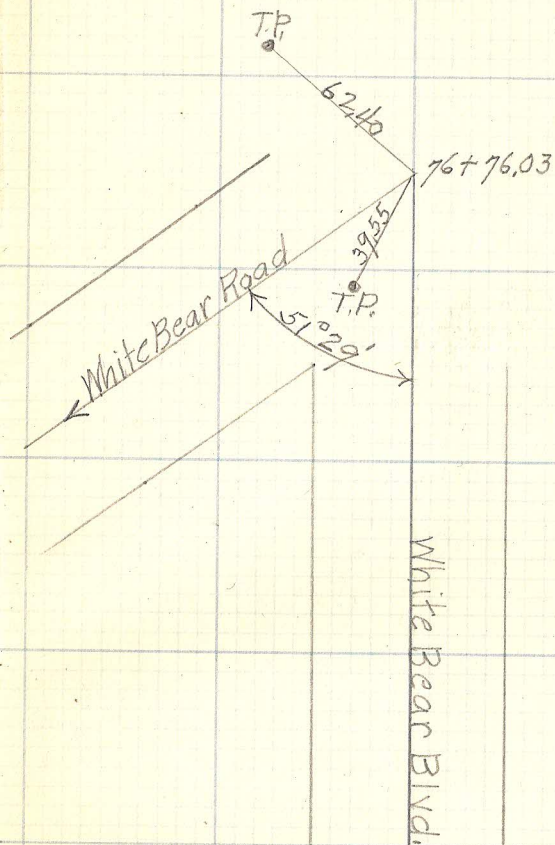

Mort.

33.
33.19
33.16
80+66.52

1716

T.P.

NE 1/4 S.W. 1/4.
SE 1/4 Sec 23
T.30, R. 22

355.11

31.20
T.P.

R=36.27
T=19.87

15" Willow


83+56

90°17'

57.26
T.P.

83+23.36

P.C.

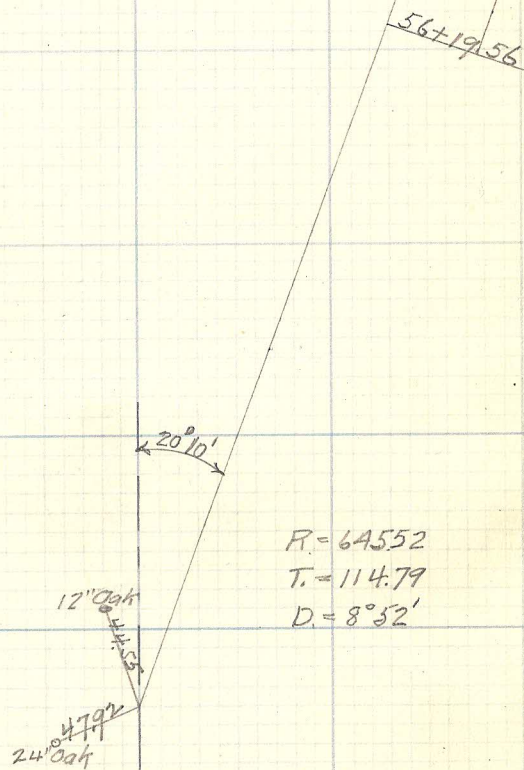

R = 64552

T = 114.79


D = $8^{\circ}52'$

White Bear Road

45.17
93+77.32
31.82
12' Oak
33, Iron

White Bear Road

73.27
5. 1/4 Cor. Sec. 23, T.30, R.22
57.16
Oak

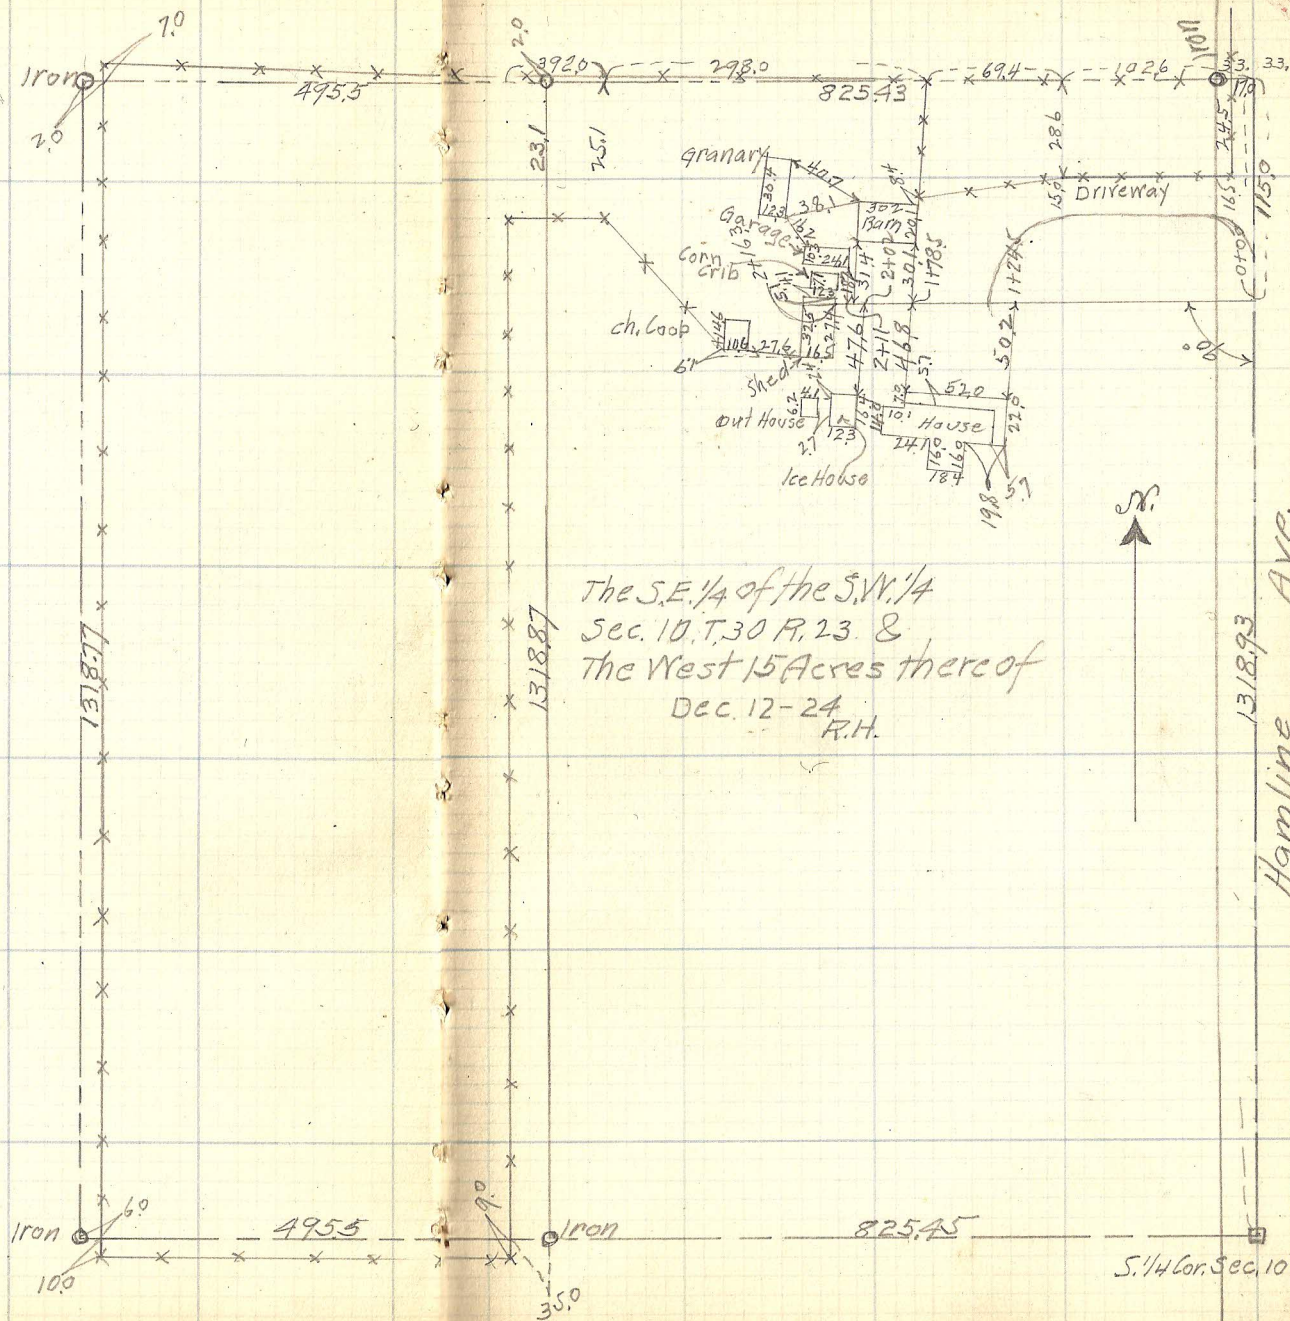

Sta	+ S	H.I	- S	Elev
	3.00	22676		223.76
	6.55	22188	11.43	215.33
0+00			12.5	209.4
+23			11.4	210.5
+30			9.1	212.8
+43			9.3	212.6
+75			8.7	213.2
1			7.7	214.2
✓			5.6	216.3
+30			4.6	217.3
3+05.9			1.2	220.7
	9.00	229.44	0.84	220.44
+33.9			7.7	221.7
+61.9			6.7	222.7
4			5.5	223.9
5			4.6	224.8
+60			4.9	224.5
6			5.9	223.5
+31.9			7.2	222.2
+61.9			8.1	221.3
+91.9			8.5	220.9
7+30			8.7	220.7
+60			8.5	220.9
+73			7.9	221.5
8			6.3	223.1
+30			5.0	224.4
+70			5.9	223.5
9			5.7	223.7
+61.9			4.4	225.0
+89.9			3.9	226.5

Mon. Cen. Montreal + Fairview

± Montreal

N. Line Montreal

S Line

C. "

N. "

S. Line

C "

N "

S. Line

C "

Bald Eagle Lake



East Line Sec. 11-30-22

Bald Eagle Lake

Bald Eagle Ave.

Lake

Oak St.

60 Beaver St.

Ave.

Park St.

Park Ave.

80 White Bear St.

West Line Sec. 11-30-22

26+39.45
24+37.7215390-
20395 50' 1/2
206

24.83

Milner St. (Vacated)

21+82.33

18' W.R.

21+80.41
78.50

Still Water

73.66

21+10.45

60.

6' Elm

25.1

25.29

Summit St.

60.00

18' B.O.

67.00

24' B.O.











30352 M.

20' B.O.

52.33

52.70

16' B.O.

52.70

16' B.O.

98.45

La Fc

Bald Eagle Lake

Lake

Ave.

22-00-11

West Line Sec.

Miller St. (vacated)

8" C.W. 5.710
 4076 18" W.O.
 20+79.63

19+83 32.81
 Iron

Iron 26.82 46.2 R
 15+56.86 35.67

26+41.72

90° 23'

15+26.38

14+96.61 35.48
 Iron

Iron 13+46.82 37.15
 Iron 13+46.38
 13+24 24.42
 Backsided
 90° 99.4

Bald Eagle Ave.

0+00

South 1/4 Cor.

Oak St.

6270 Beaver St.

White

Bear St.

E/K St.

East St.

Eagle

13+17.65 112.50
 022.58 stump

2340.

6
 66.84
 80
 5862
 2605.46
 80
 89.85

0+00