


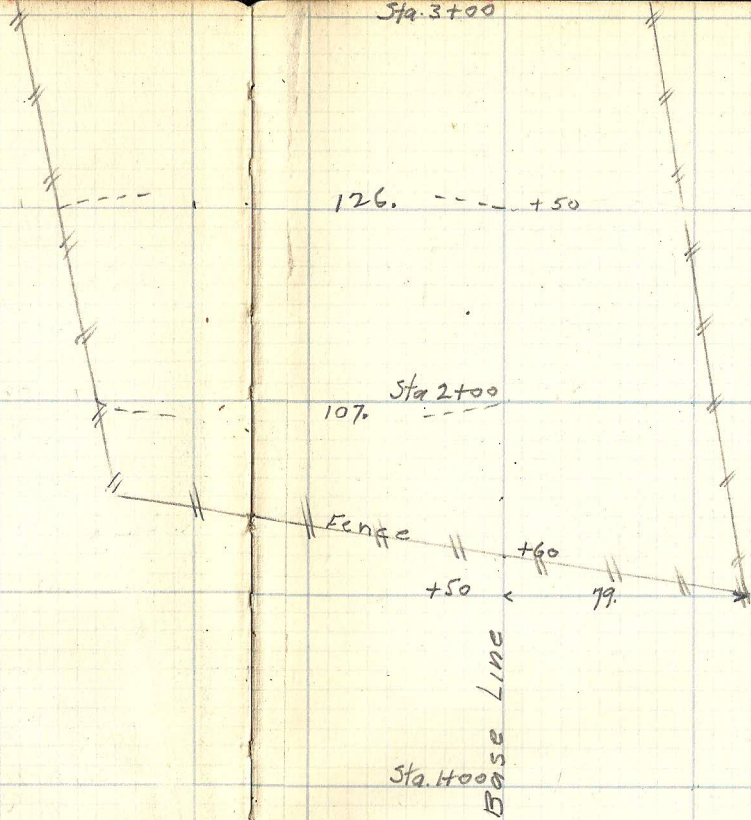

Level Notes

Book 82 P. 113

Alignment
Drainage Area
Book 82 P. 122

Oct. 1 - 23
R.H.

