
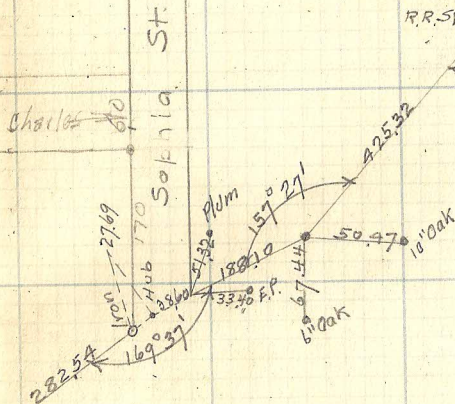
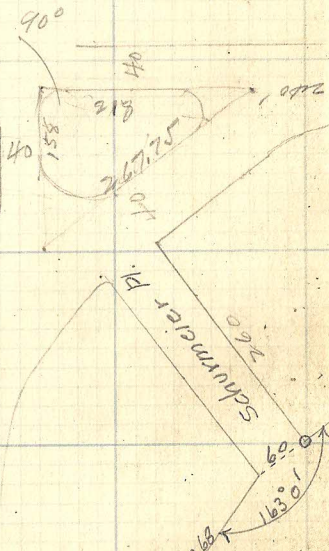


N.E. 1/4 Sec. 16


1268.25
267.78

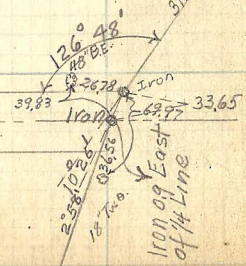

Dec. 1923
R.H.

East Line Sec. 16

✕

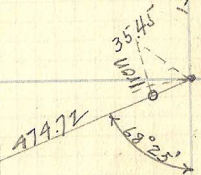

South Line Sec. 16 T. 29 R. 22

1552.82

S.E. Cor. Sec. 16
T. 29 R. 22