


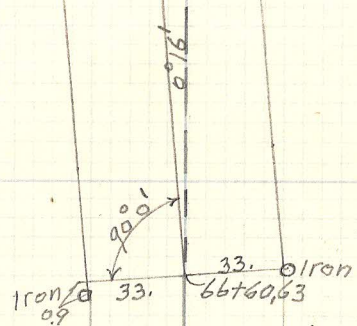

$69+24.48$ $33.$ Iron