


Bald Eagle Lake

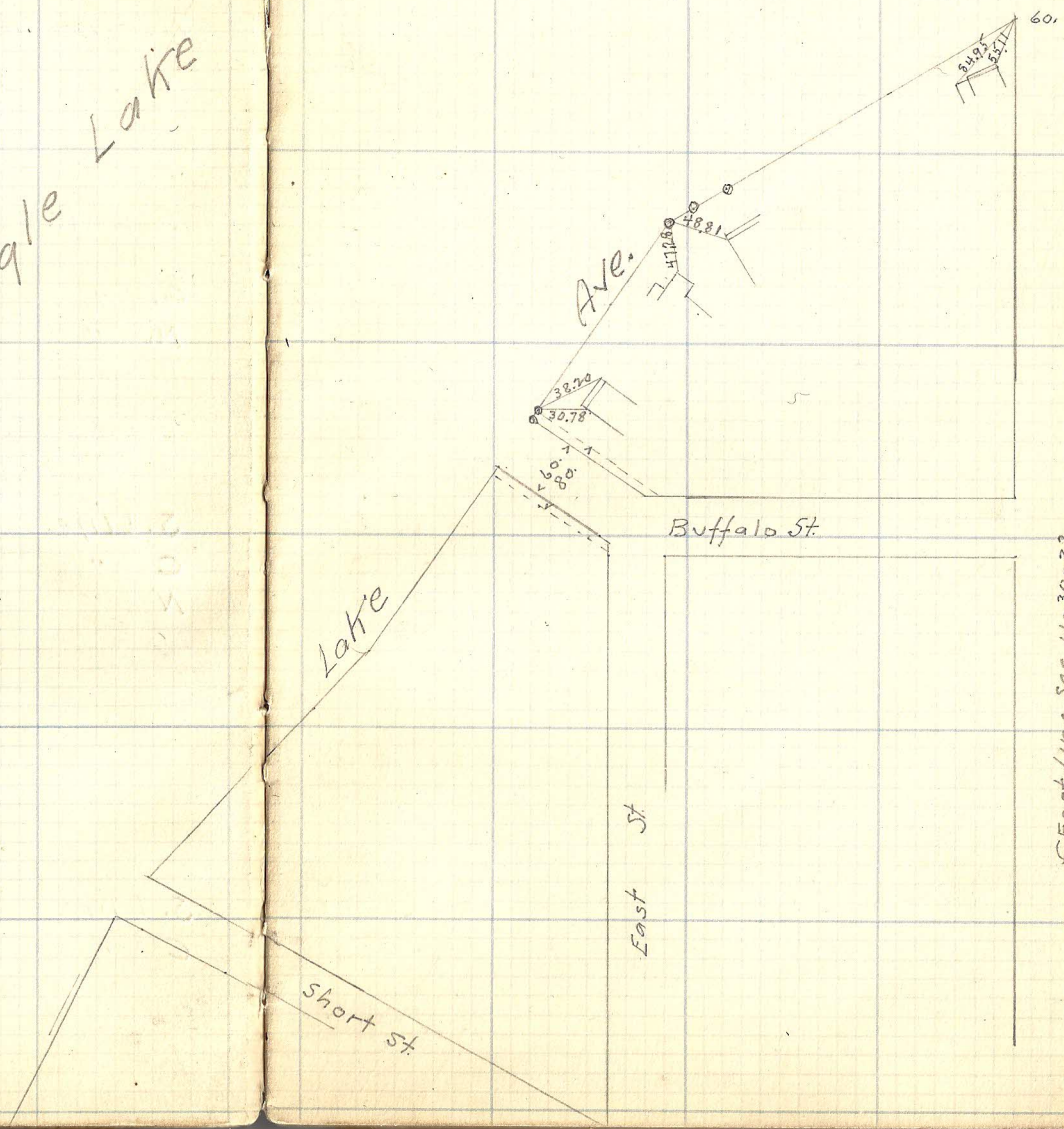

East Line Sec. 11-30-22