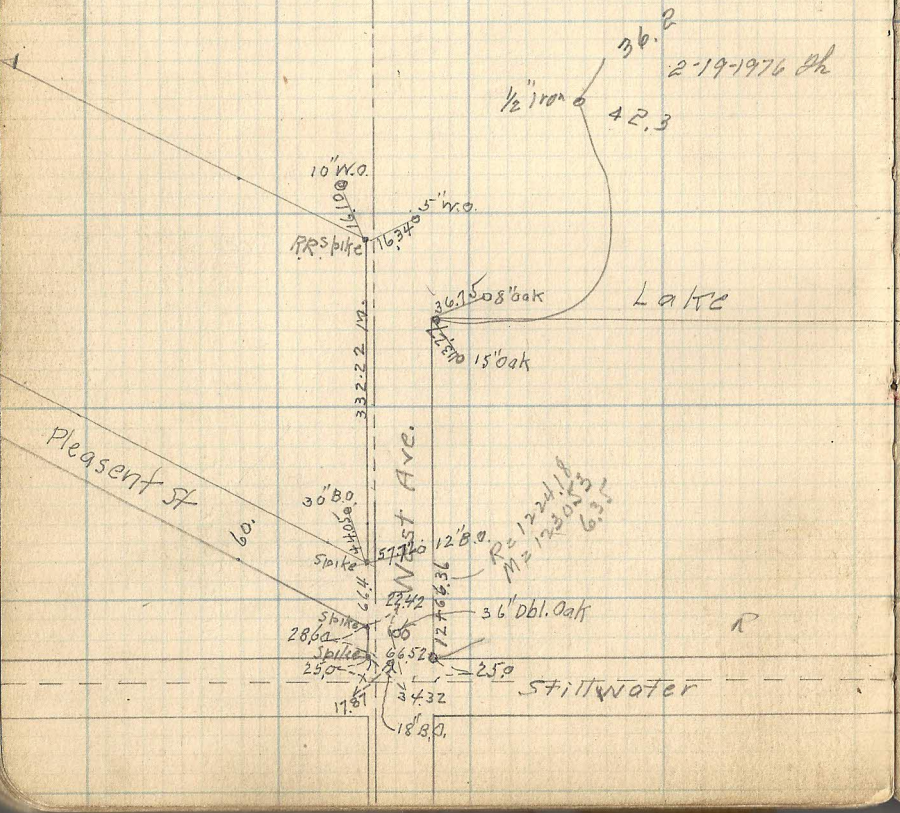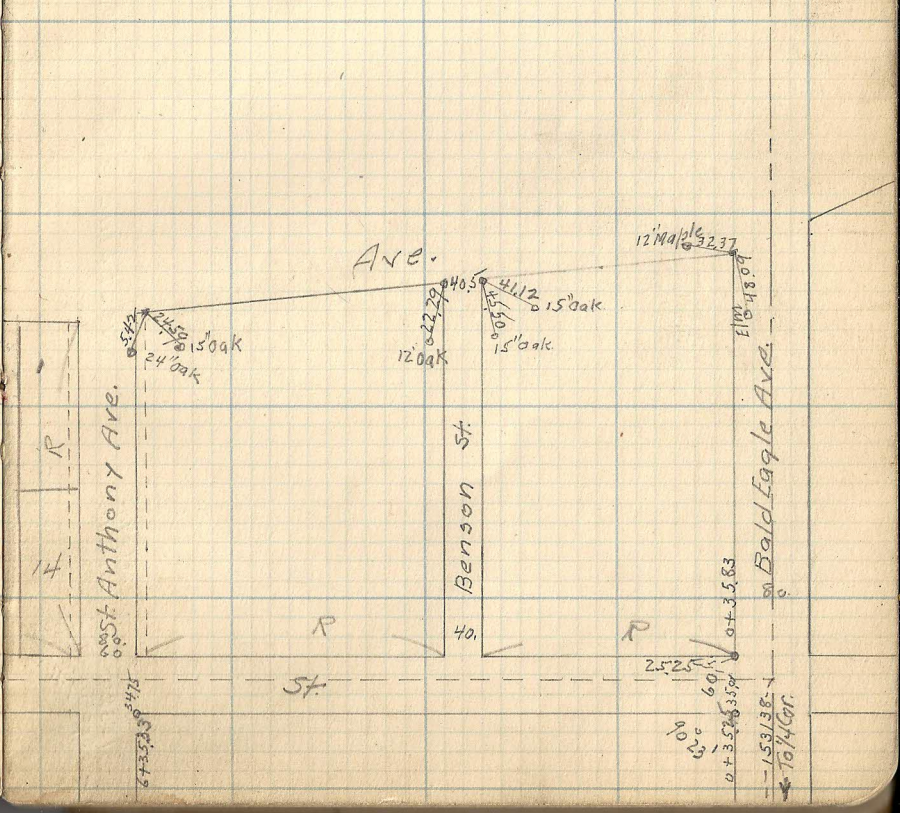Bald Eagle Lake.