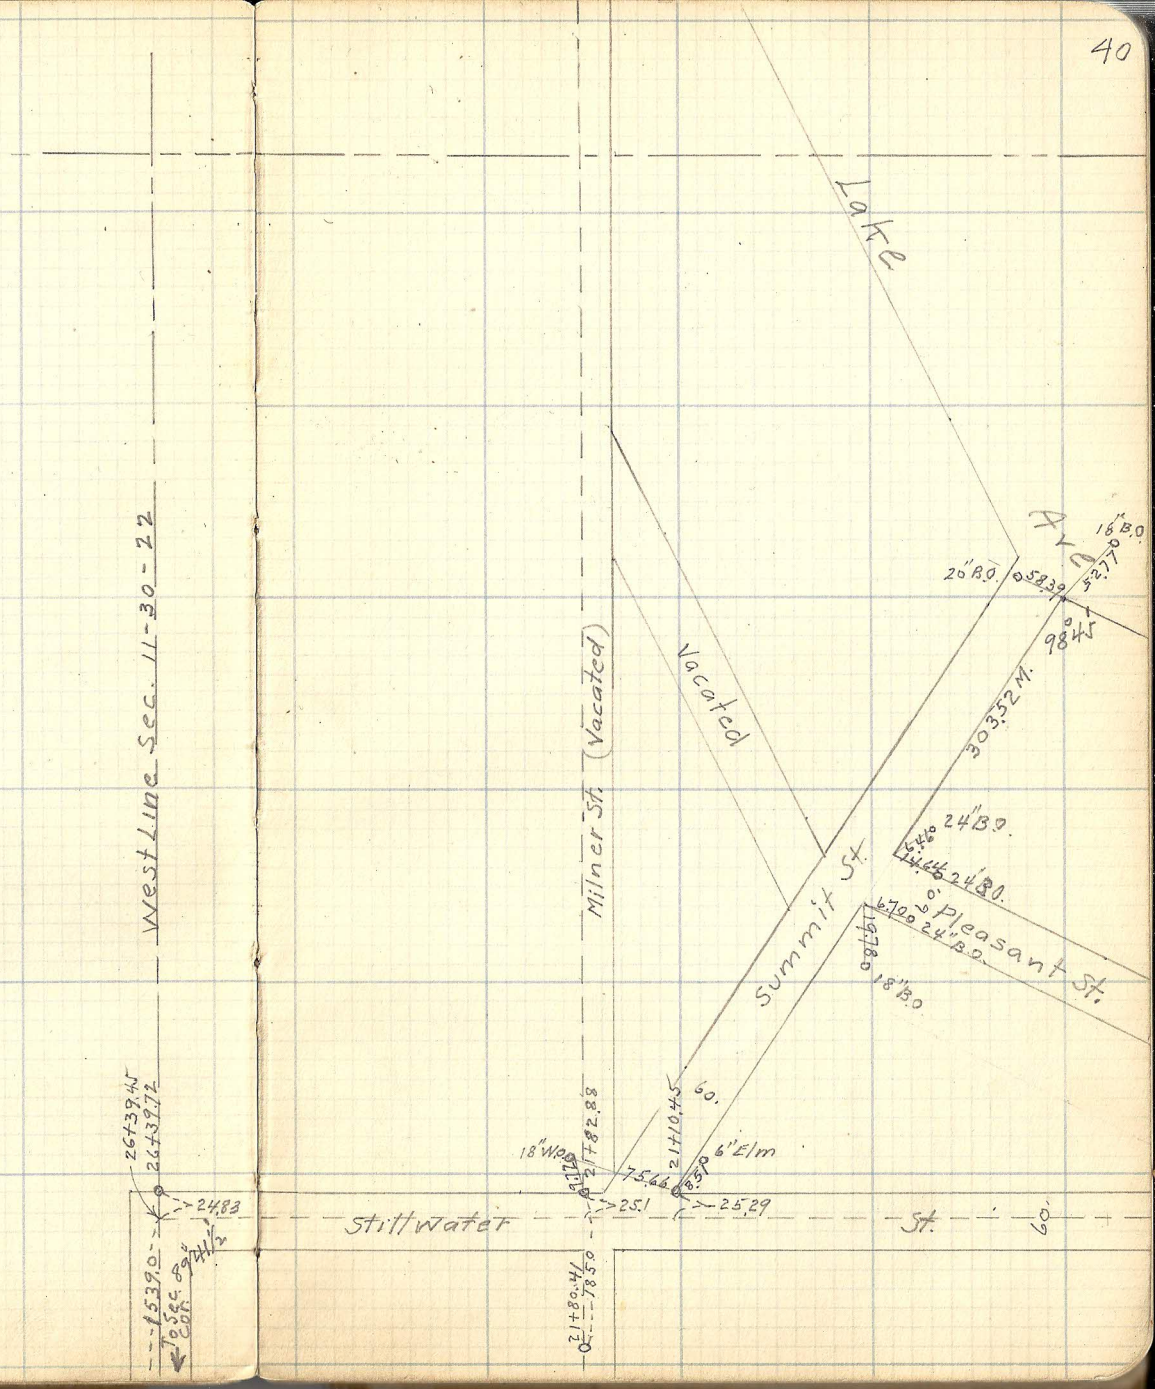
West Line Sec. 11-30-22
Milner St. (Vacated)
Vacated
Lake
Ave.
Summit St.
6' Pleasant St.
Stillwater
St.
60'
16" B.O.
20" B.O.
30.352 M.
24" B.O.
24" B.O.
24" B.O.
18" B.O.
18" W.O.
6" Elm
60.
26+38.45
26+39.72
24.83
15.39
70 Sec. Cor.
21+82.88
21+10.45
21+80.41
78.50
75.66
25.1
25.29
119.80
67.00
53.77
98.45