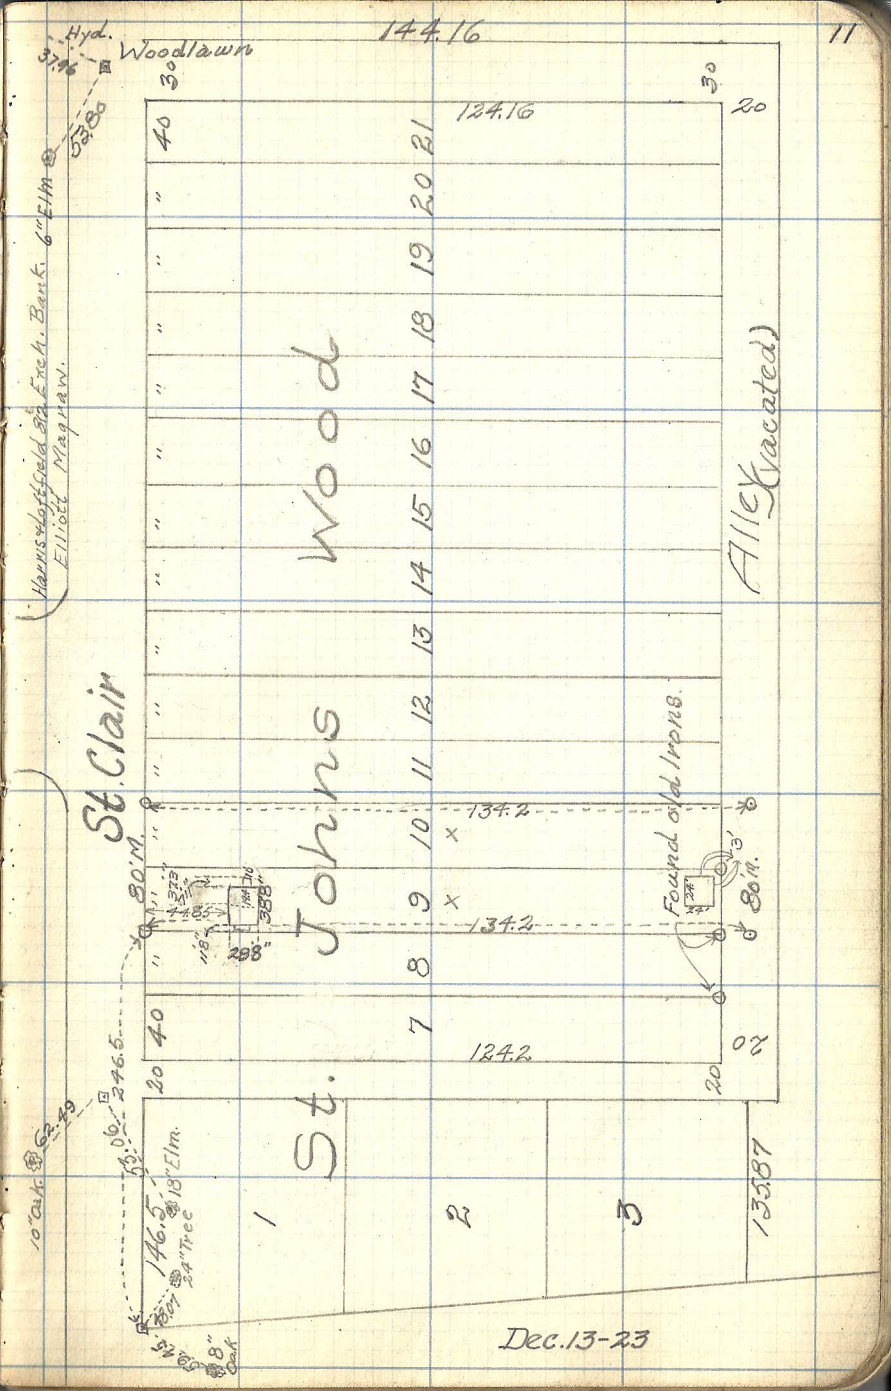
144.16
Hyd.
Woodlawn
37.46
53.80
Harris & Loftfield 8½ Exch. Bank. 6" Elm
Elliott Magraw.
St. Clair
St. Johns Wood
Alley (vacated)
124.16
134.2
134.2
124.2
80' M.
80' M.
Found old Irons.
146.5
18" Elm.
24" Tree
10" Oak
62.49
246.5
135.87
Dec. 13-23