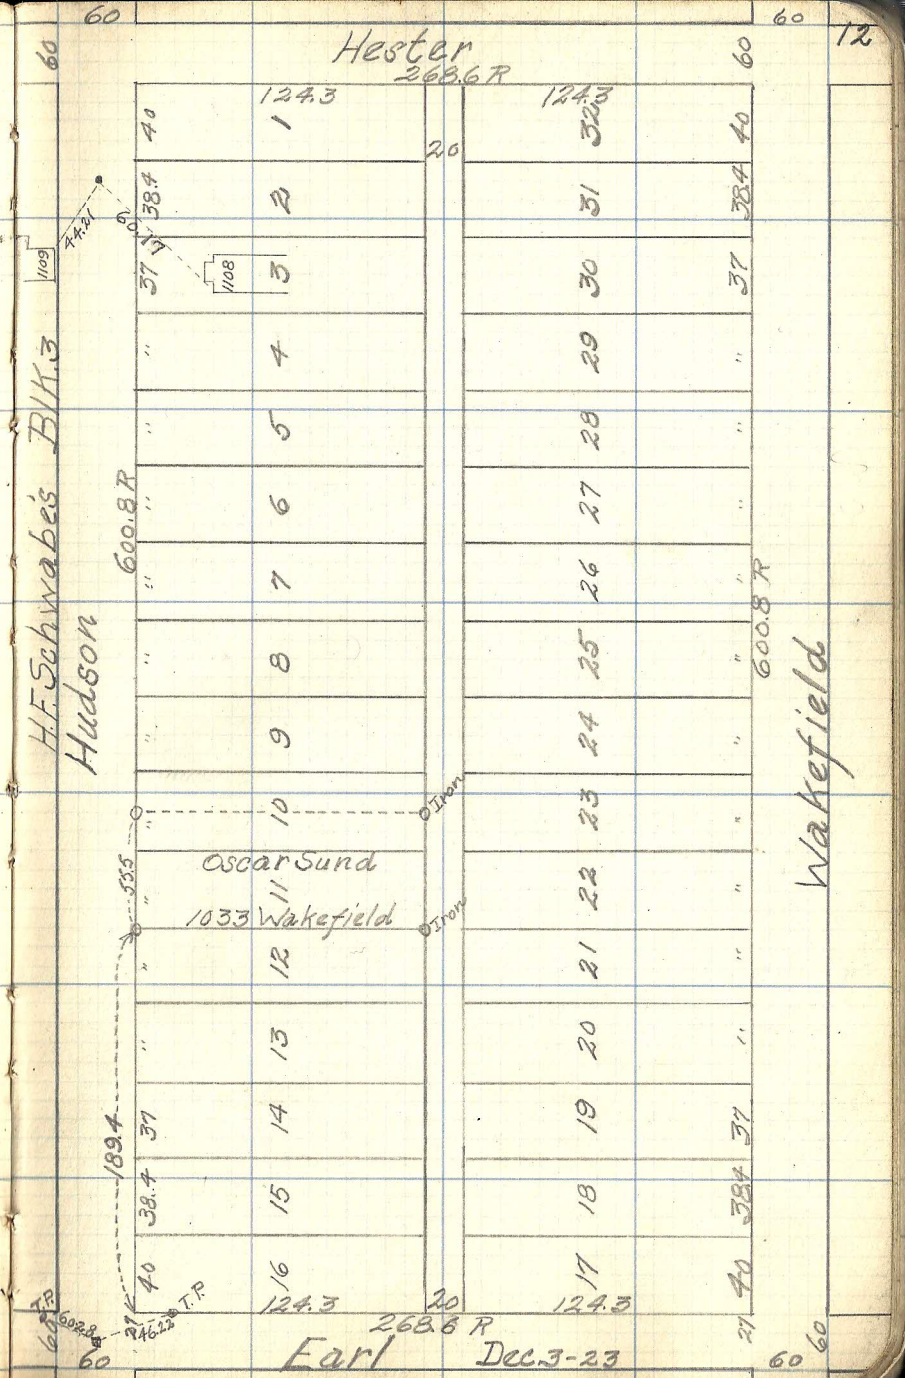
Hester
268.6 R
124.3
124.3
H.F. Schwabe's Blk. 3
Hudson
600.8 R
Wakefield
600.8 R
Oscar Sund
1033 Wakefield
Iron
Iron
189.4
55.5
44.21
60.17
1109
1108
T.P.
T.P.
602.8
46.22
268.6 R
Earl
Dec. 3-23
60
60
60
60
60
60
60
60
60
60
40
38.4
37
40
38.4
37
40
38.4
37
40
38.4
37
40
20
20
20
27
27
1
2
3
4
5
6
7
8
9
10
11
12
13
14
15
16
17
18
19
20
21
22
23
24
25
26
27
28
29
30
31
32