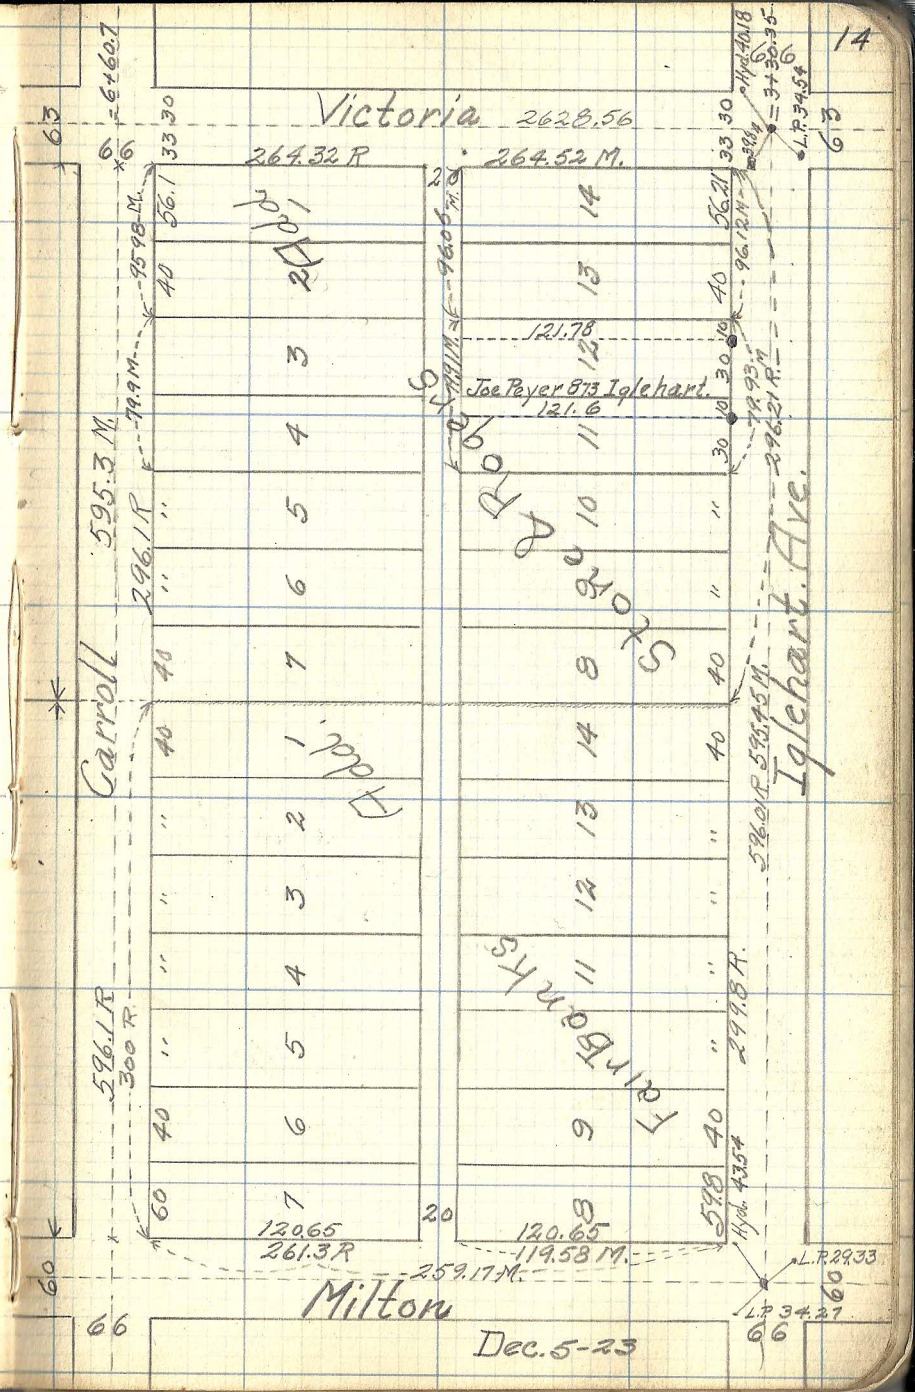
Victoria
2628.56
264.32 R
264.52 M.
Carroll
595.3 M.
596.1 R
300 R.
Iglehart Ave.
Joe Peyer 873 Iglehart.
121.78
121.6
Milton
120.65
261.3 R
120.65
119.53 M.
259.17 M.
Dec. 5-23