


Owasso Add BIK 9-10


Owasso

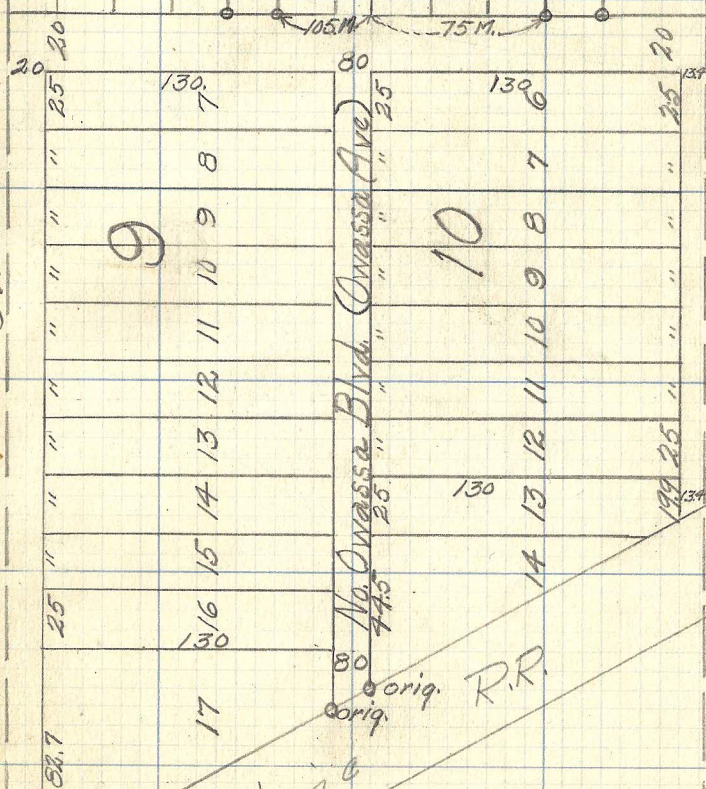

Soo. Line

Nov. 2-23

Rice St.

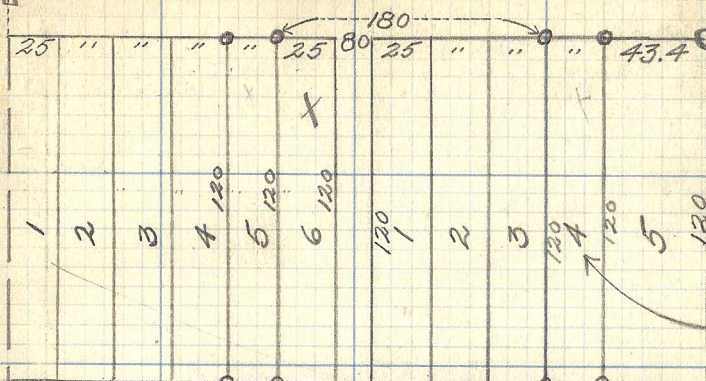

orig.
Martin Flogerzi
848 Ottawa