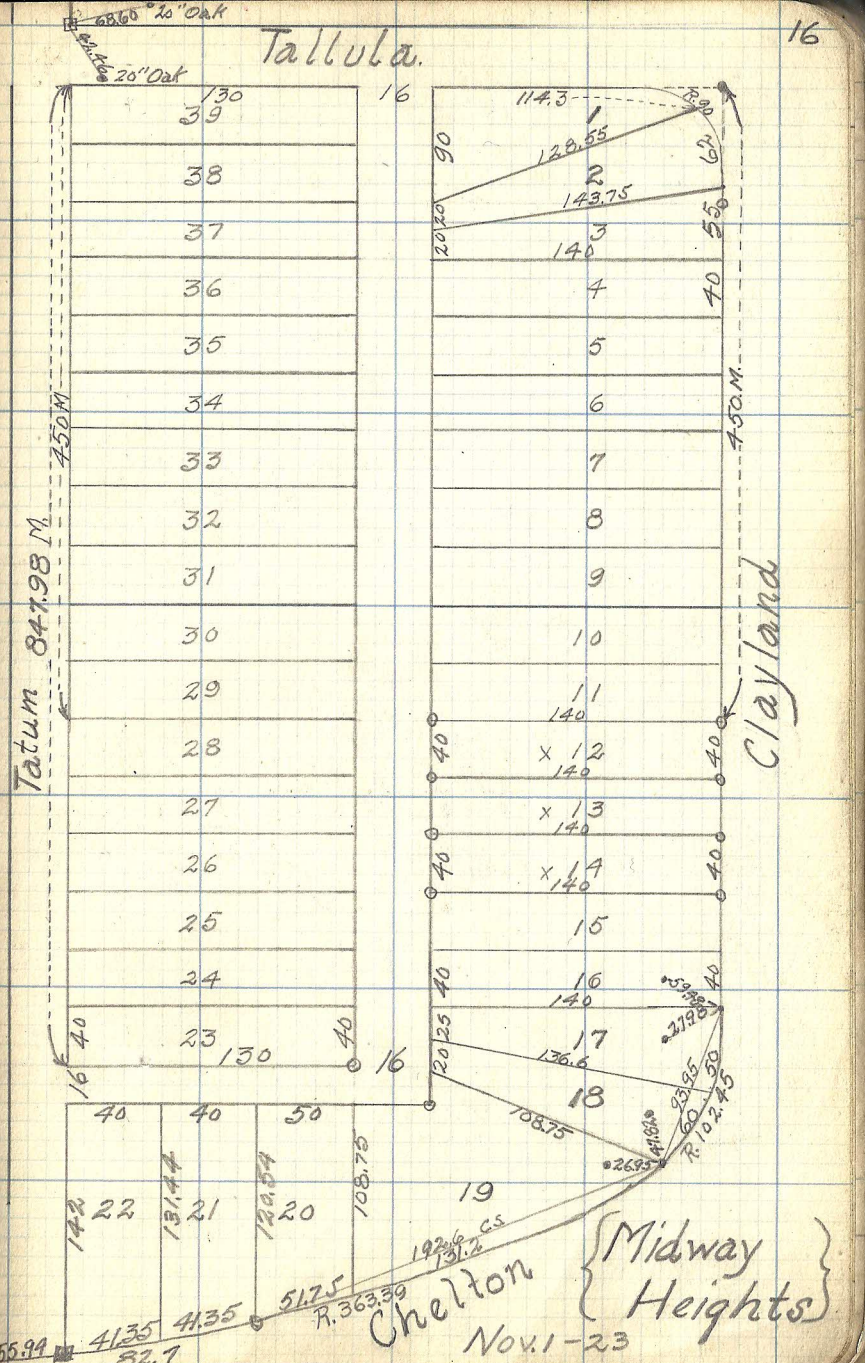
Tallula.
68.60 20" Oak
20" Oak
Tatum 847.98 M.
450 M.
Clayland
450 M.
Chelton
Midway Heights
Nov. 1-23
R. 363.39
R. 102.45
R. 90
114.3
128.55
143.75
136.6
108.75
192.6 C.S.
131.2
51.75
41.35
41.35
82.7
55.94
142
131.44
120.54
108.75
130
140
40
50
90
62
55
20
25
27.98
93.95
26.95
1
2
3
4
5
6
7
8
9
10
11
12
13
14
15
16
17
18
19
20
21
22
23
24
25
26
27
28
29
30
31
32
33
34
35
36
37
38
39