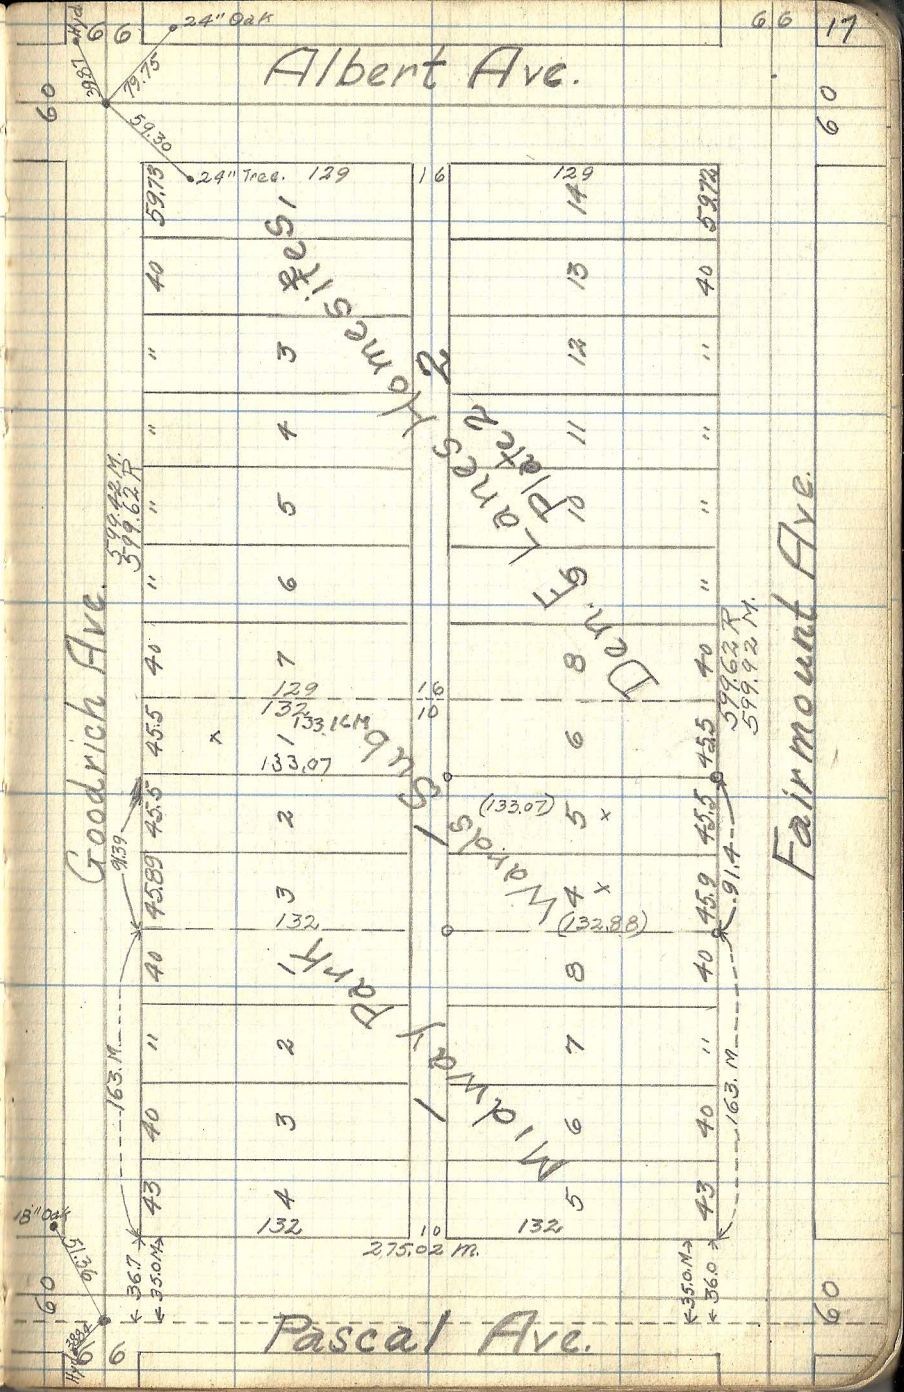
Albert Ave.
Pascal Ave.
Goodrich Ave.
Fairmount Ave.
Midway Park
Wards Sub
Dem. E. Lanes Homesites
Plate 2
24" Oak
24" Tree
18" Oak
Hyd.
39.87
79.75
59.30
59.73
59.72
599.42 M.
599.62 R.
599.92 M.
133.1 CM
133.07
(133.07)
(132.88)
91.39
91.4
163. M.
275.02 m.
36.7
35.0 M.
36.0
51.36
129
132
16
10
60
66