


Manson & Simontons Bk. 3

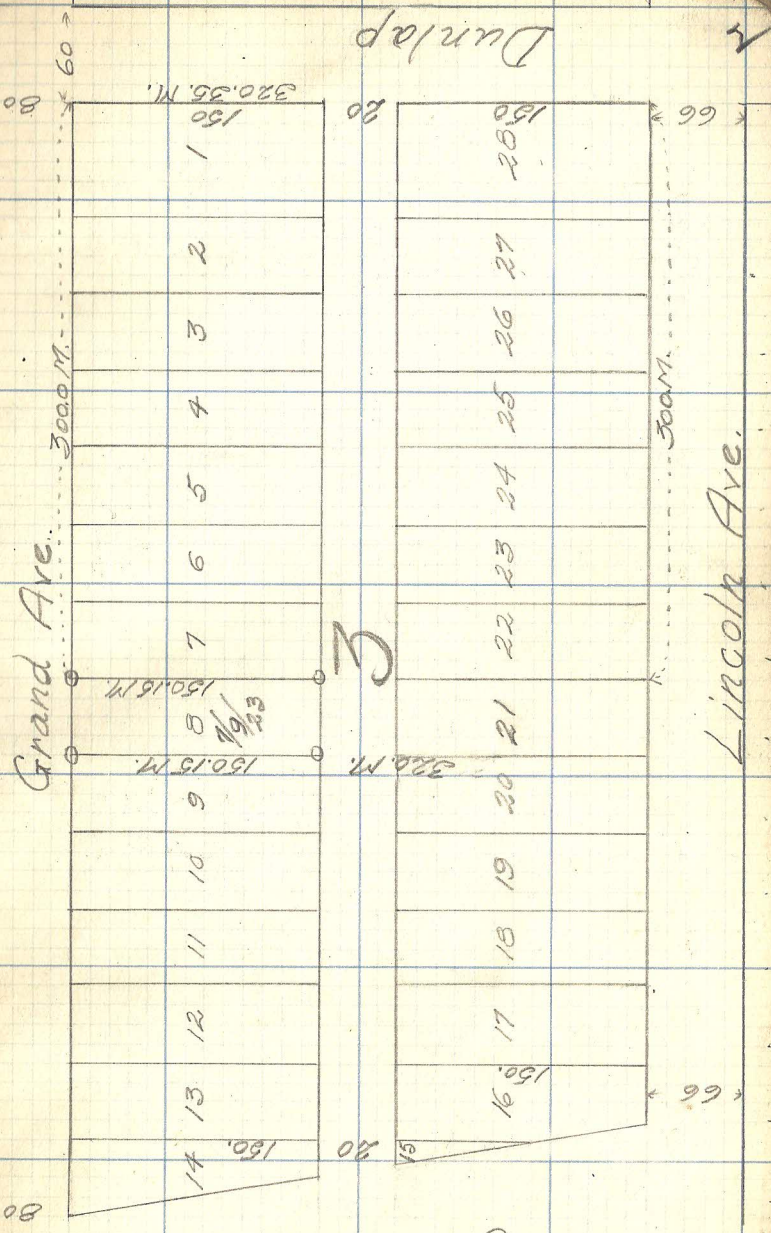

C.M. & ST.P.R.Y. July 9-23