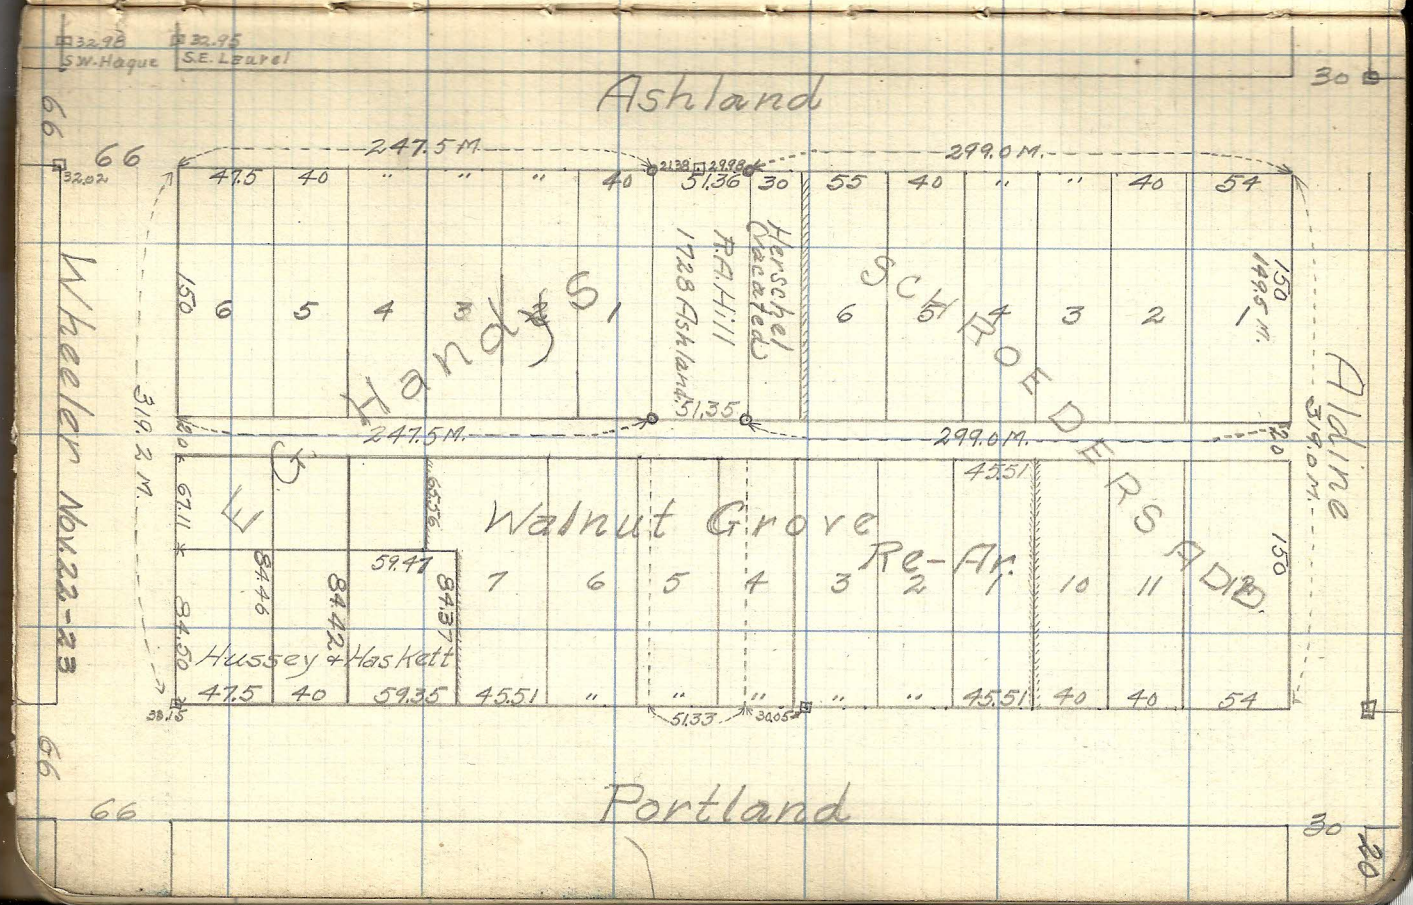
32.98
S.W. Haque
32.95
S.E. Laurel
Ashland
247.5 M.
299.0 M.
Wheeler Nov. 22-23
Handy's
Herschel Vacated
R.A. Hill
1728 Ashland
Schroeders Add.
Walnut Grove Re-Ar.
Hussey & Haskett
Aldine
Portland