


66 443787

Underwood 3rd Add. Bk 6 Lot 8

Princeton

60

60

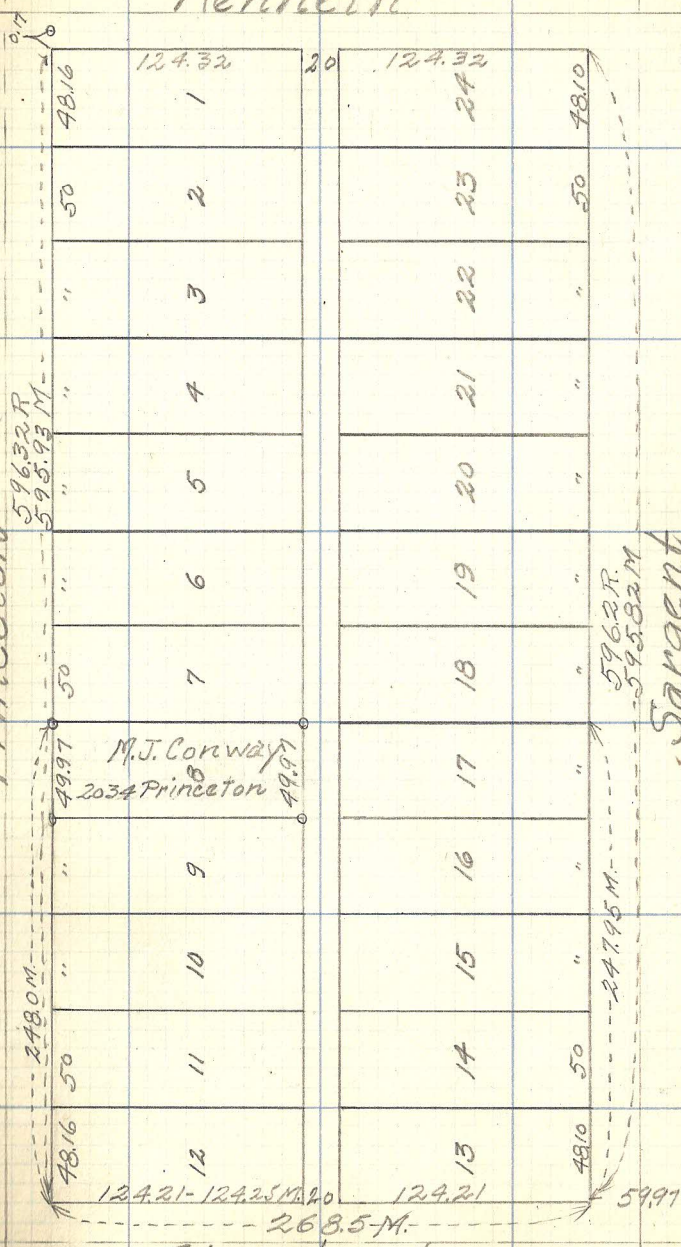

Kenneth

60

60 21

4826.07
5124.22 StClain

66

Cleveland Nov. 2023

60