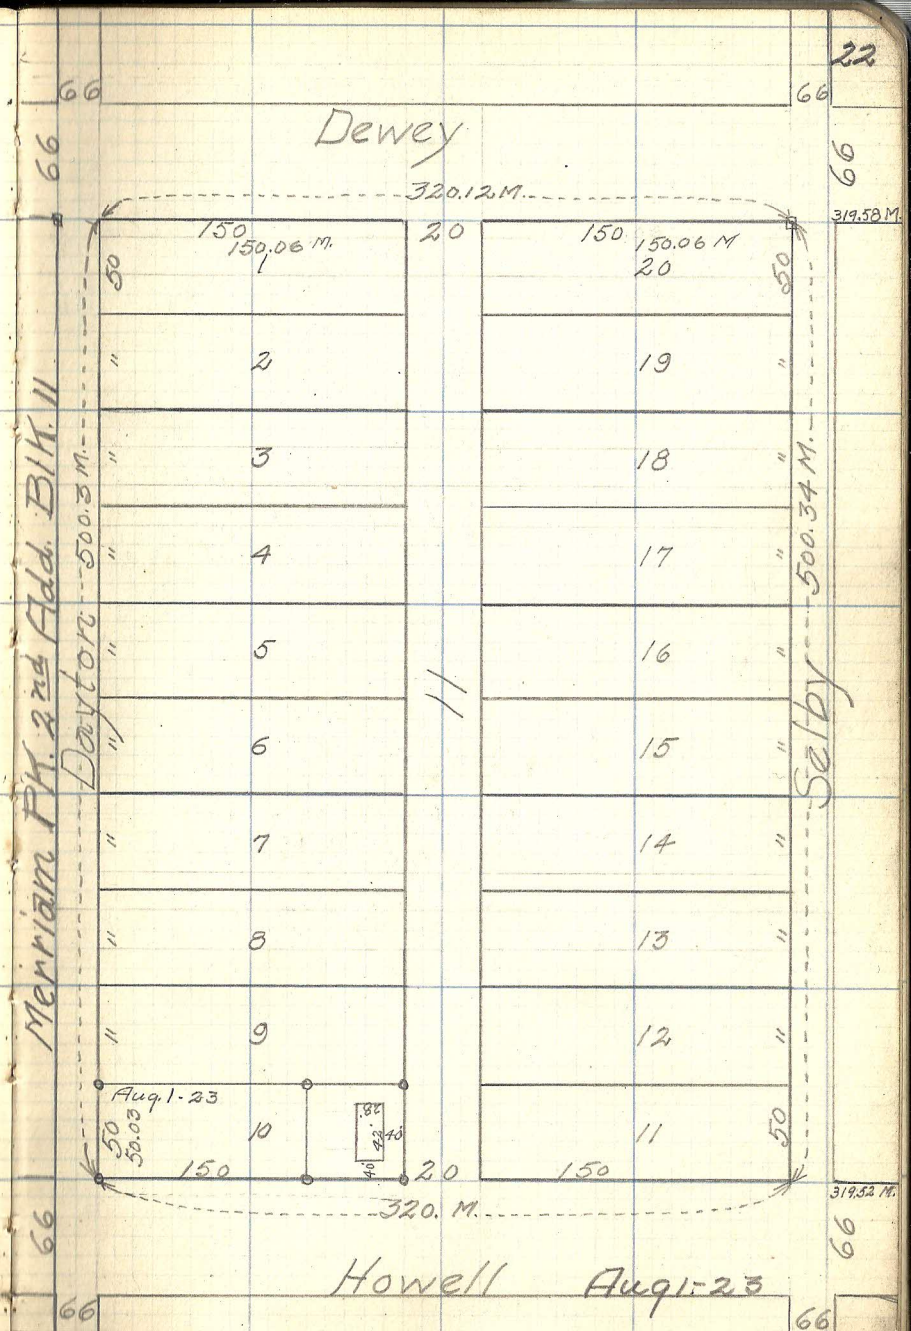
66
Dewey
320.12 M.
319.58 M.
150
150.06 M.
20
150
150.06 M
20
50
1
2
19
3
18
4
17
5
16
6
15
7
14
8
13
9
12
10
11
Merriam Pk. 2nd Add. Blk. 11
Dayton 500.3 M.
Selby 500.34 M.
Aug. 1-23
50.03
150
20
150
320. M.
319.52 M.
Howell Aug 1-23