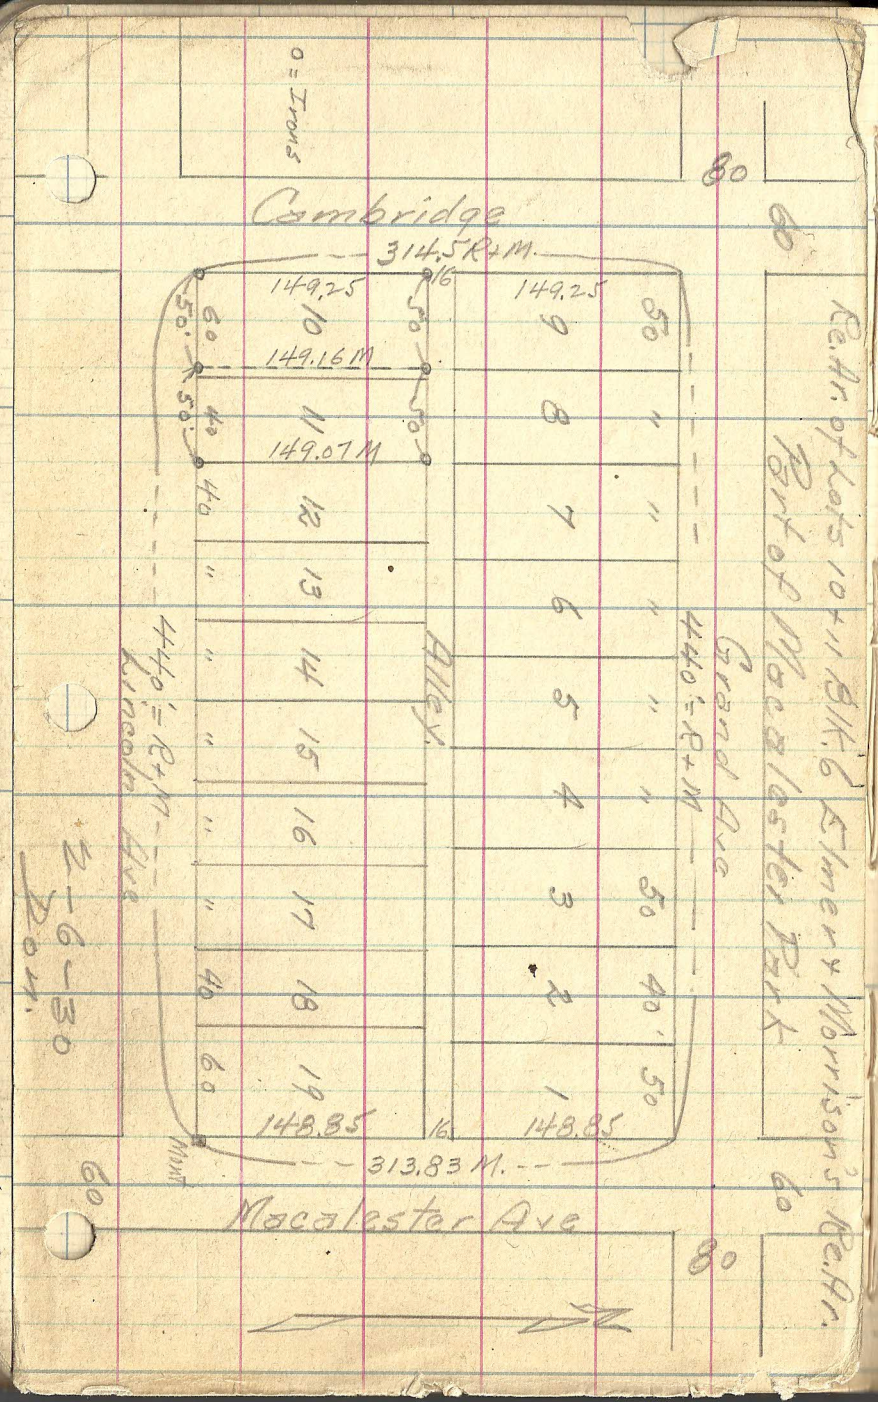

Cambridge
314.5 R+M.
149.25
149.16 M
149.07 M
148.85
313.83 M.
Alley
Macalester Ave
Lincoln Ave
440' = R+M
Grand Ave
Re. Ar. of Lots 10+11 Blk. 6 Elmer + Morrison's Re. Ar.
Part of Macalester Park
2-6-30
Don.

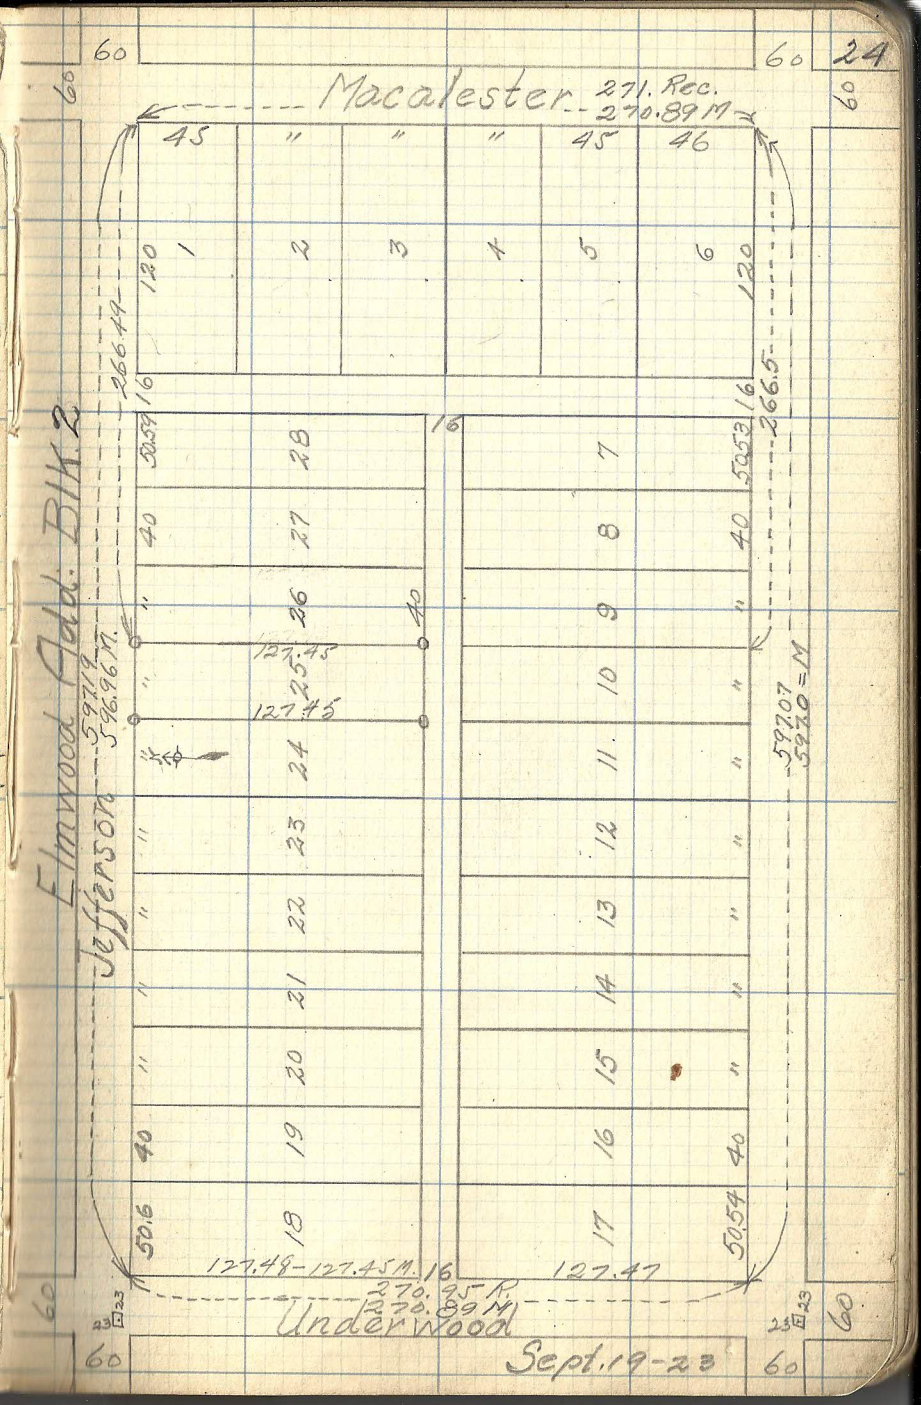

24
Macalester
271. Rec.
270.89 M
Elmwood Add. Blk. 2
Jefferson
Underwood
127.45
127.48-127.45 M.
127.47
270.95 R.
270.89 M
266.49
266.5
Sept. 19-23