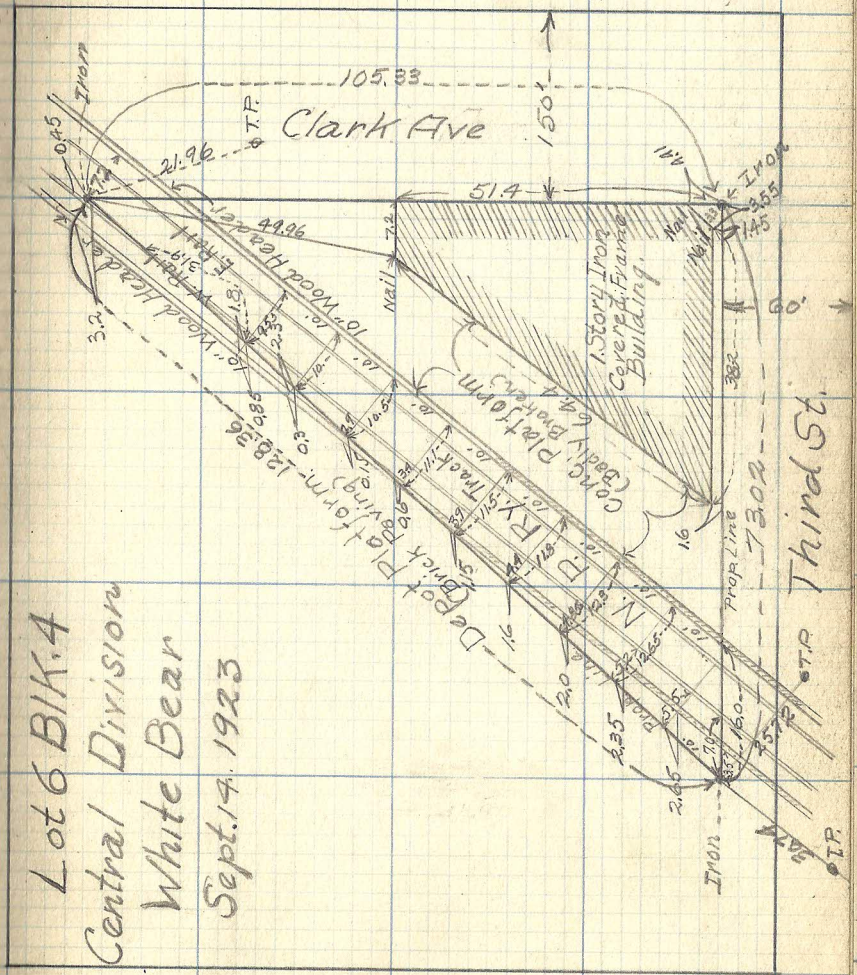
Clark Ave
105.83
150
51.4
21.96
49.96
Iron
T.P.
Nail
1-Story Iron Covered Frame Building
Wood Head
Wood Platform
Concrete Platform
Track
Pit
Depot
Proj. Line
60.
Third St.
T.P.
I.P.
Lot 6 Blk 4
Central Division
White Bear
Sept. 14. 1923
Sept. 14-23