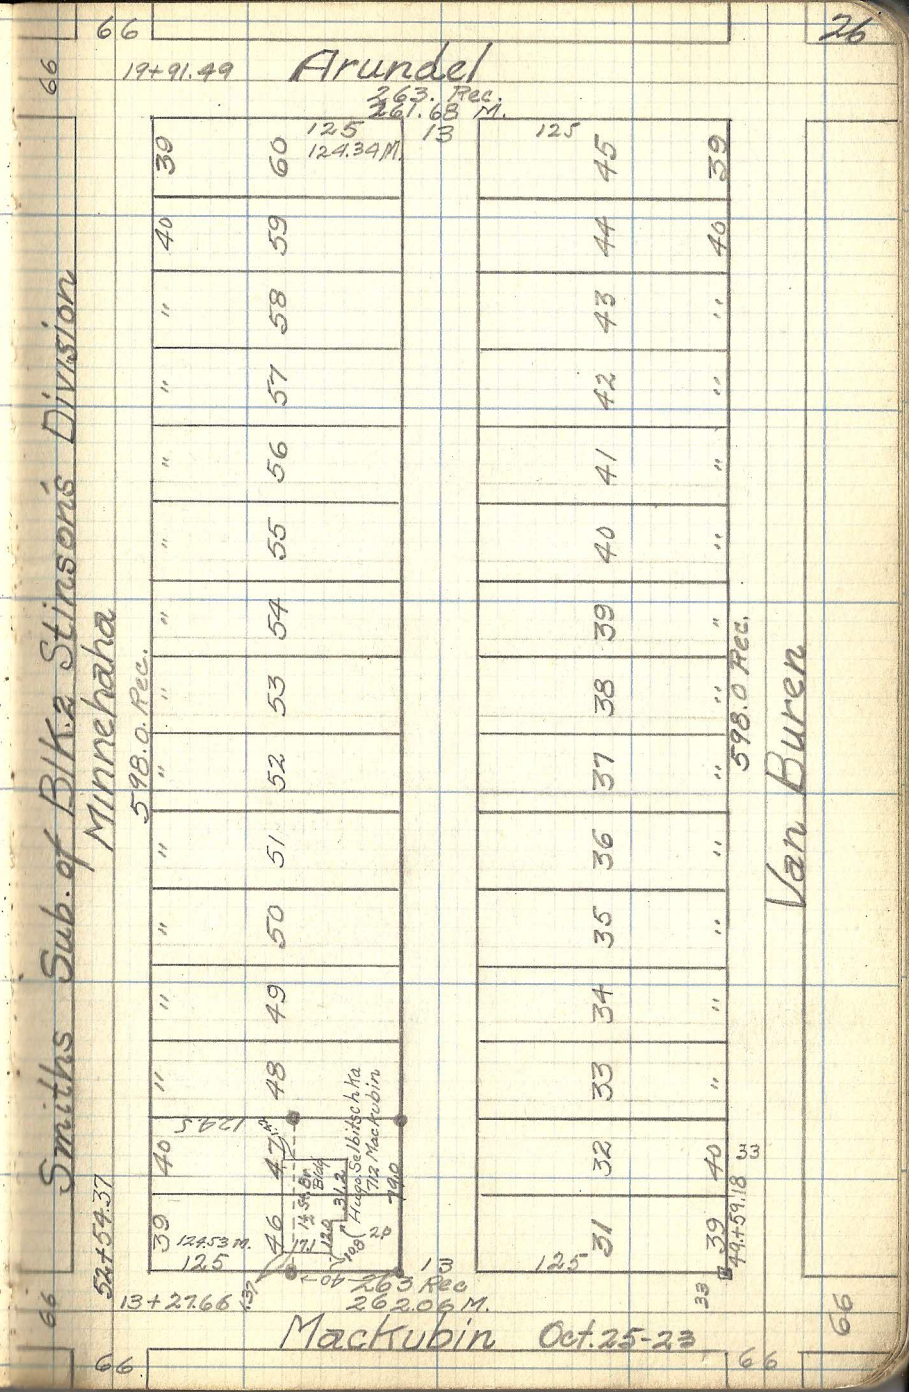
Arundel
19+91.49
263 Rec.
261.68 M.
125
124.34 M.
13
Smiths Sub. of Blk 2 Stinsons Division
Minnehaha
598.0 Rec.
Van Buren
598.0 Rec.
53+54.37
13+27.66
263 Rec
262.06 M.
44+59.18
Mackubin
Oct. 25-23
Hugo Selbitschka
742 Mackubin
124.53 M.
125
124
100
40
20
33
38