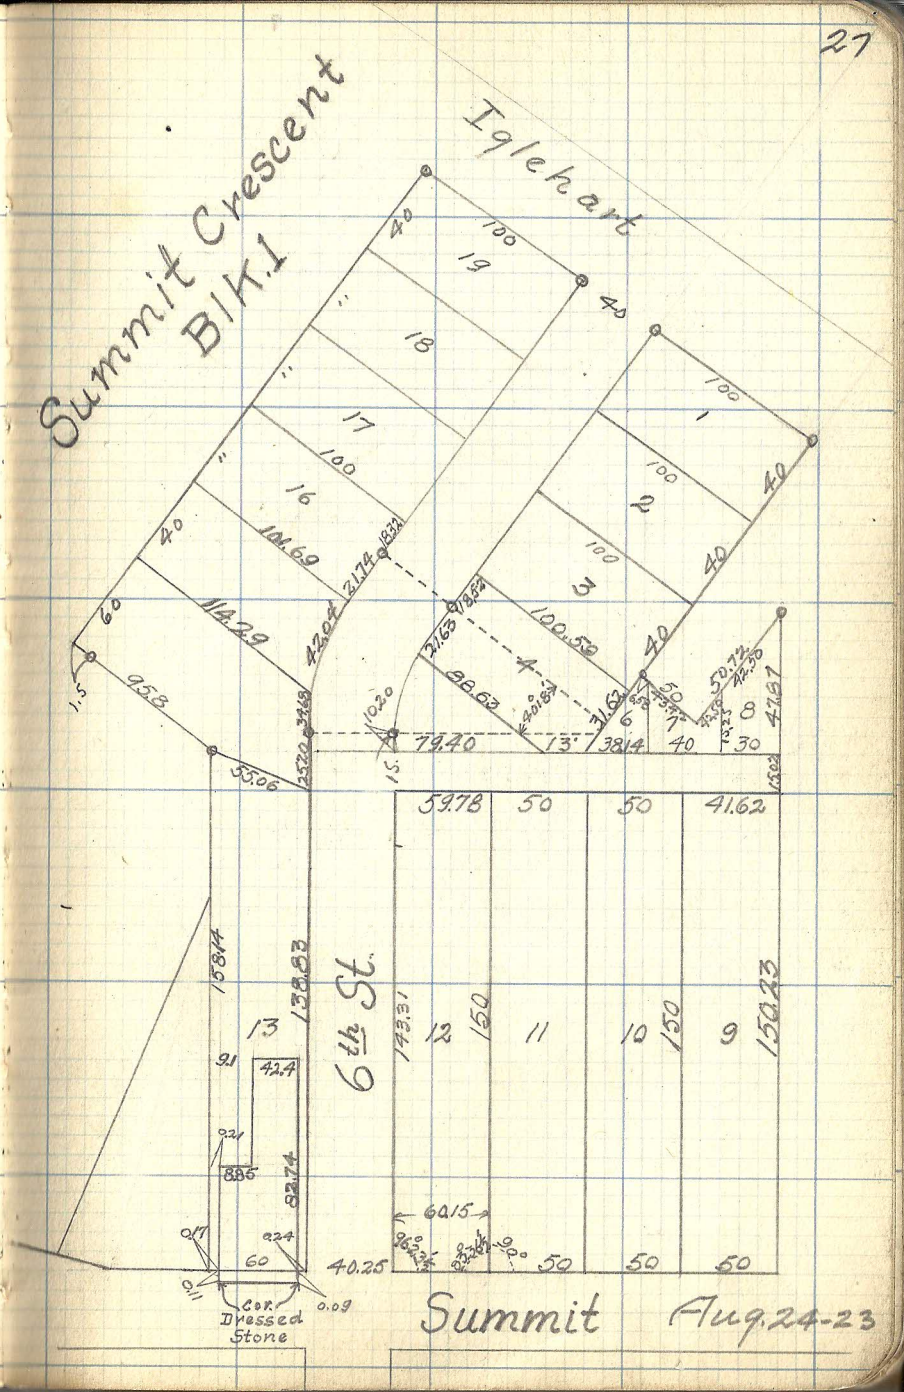
Summit Crescent
Blk.1
Iglehart
6th St.
Summit
Cor. Dressed Stone
Aug. 24-23