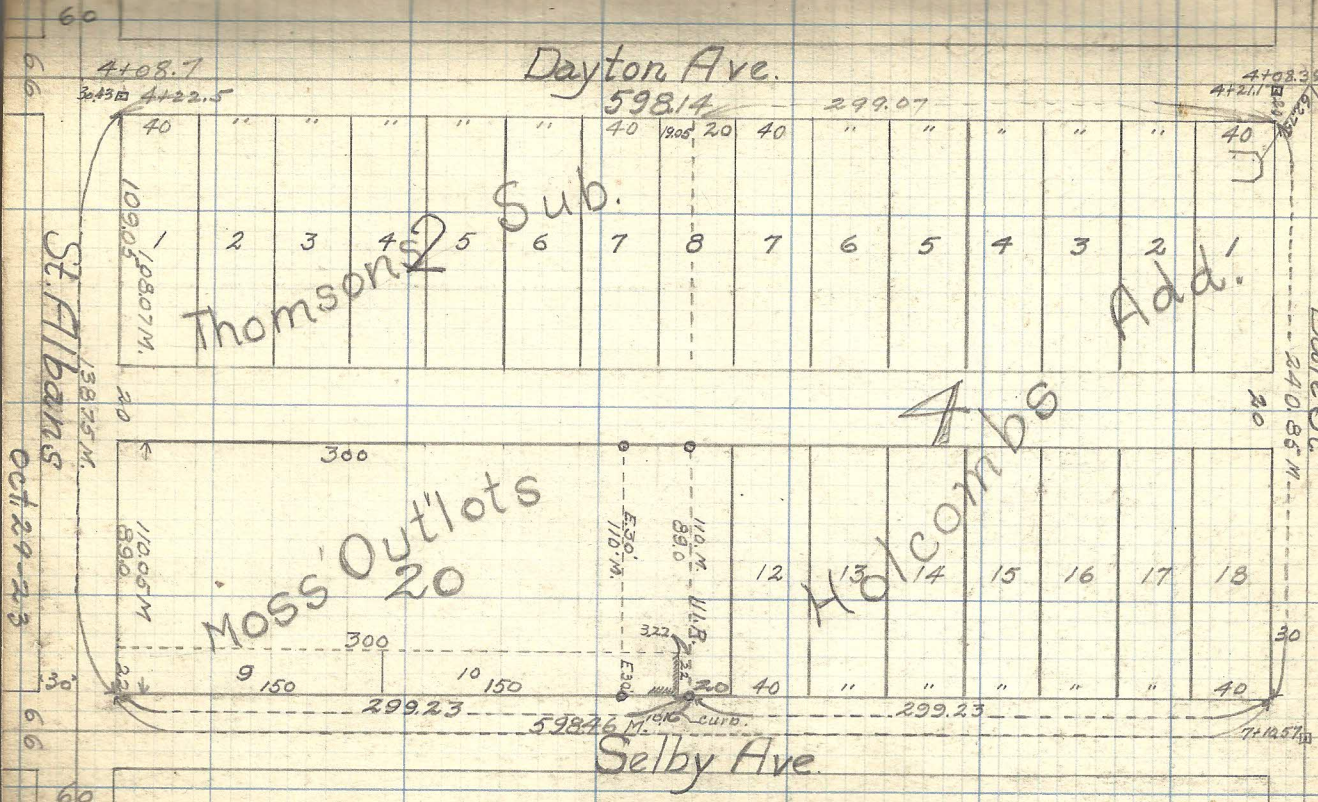
Dayton Ave.
59814
299.07
4+08.7
4+22.5
4+08.39
4+21.1
Thomsons 2 Sub.
Holcombs Add.
Moss' Outlots 20
St. Albans
Dale St.
Selby Ave.
299.23
299.23
59846 M.
curb.
Oct 29-23