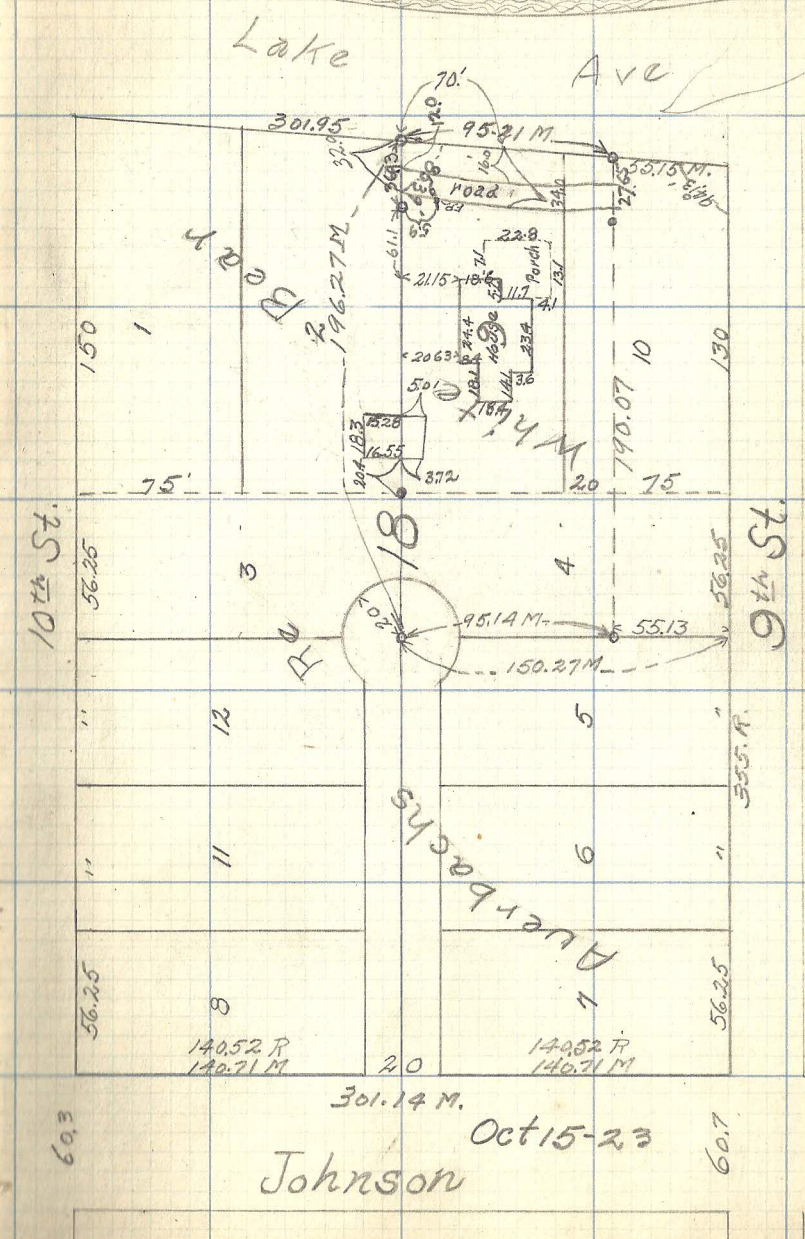White Bear Lake