


Chute Bros. Div No. 7

Charles

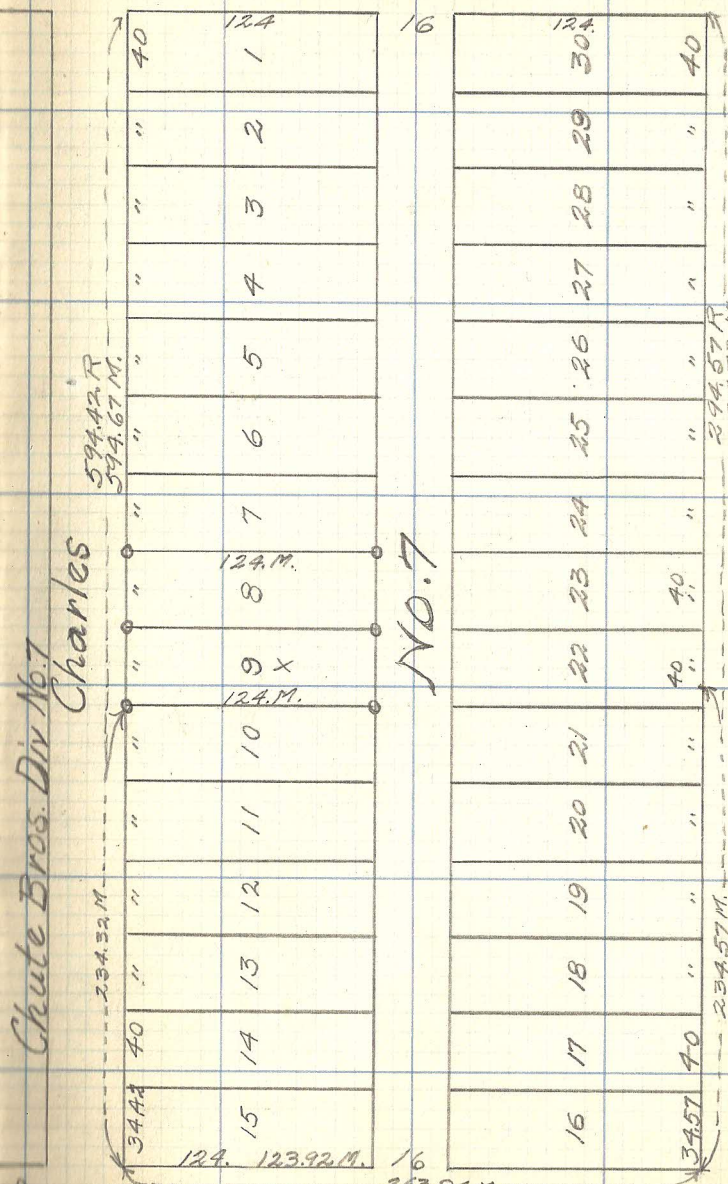

Grotto Sept 20-23

Sherburne