


Lawton Bros. Fld.
B.K. 61

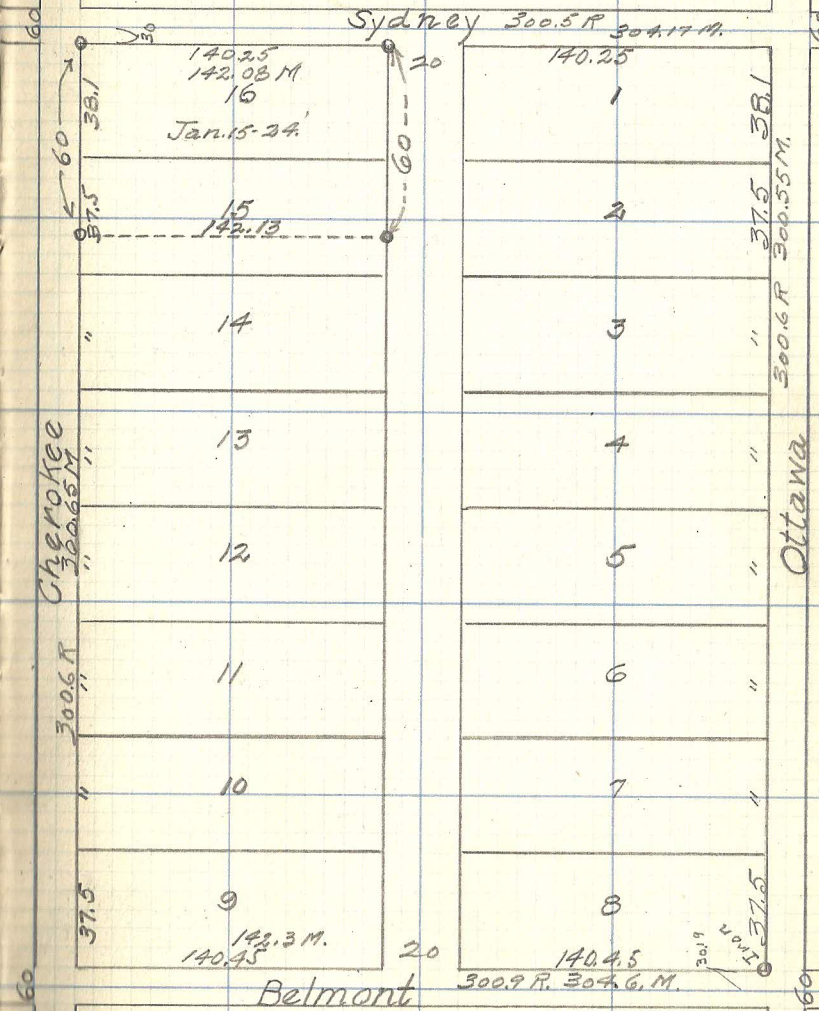

140.25
142.03 M
16
Jan. 15-24

Sydney 300.5 R 304.17 M.

Cherokee
300.6 R

Ottawa
300.6 R 300.55 M.

Belmont

Jan 15-24

60

60

60

60

30

37.5

37.5

20

20

140.25

15
142.13

14

13

12

11

10

9

142.3 M.
140.45

1

2

3

4

5

6

7

8

300.9 R 307.6 M.
140.45

38.1

37.5

37.5

300.6 R