340.9
30.7
371.6

578.2
371.6
206.6

340.9
30.7
371.6

578.2
371.6
206.6

30.7
24.3
16.
20.
31
31
27.
27.
27.
237.00

8.24
150.
17.2
32.8
18.
33.
49.
10.5
340.9
237
577.9

7

340.9
340.9
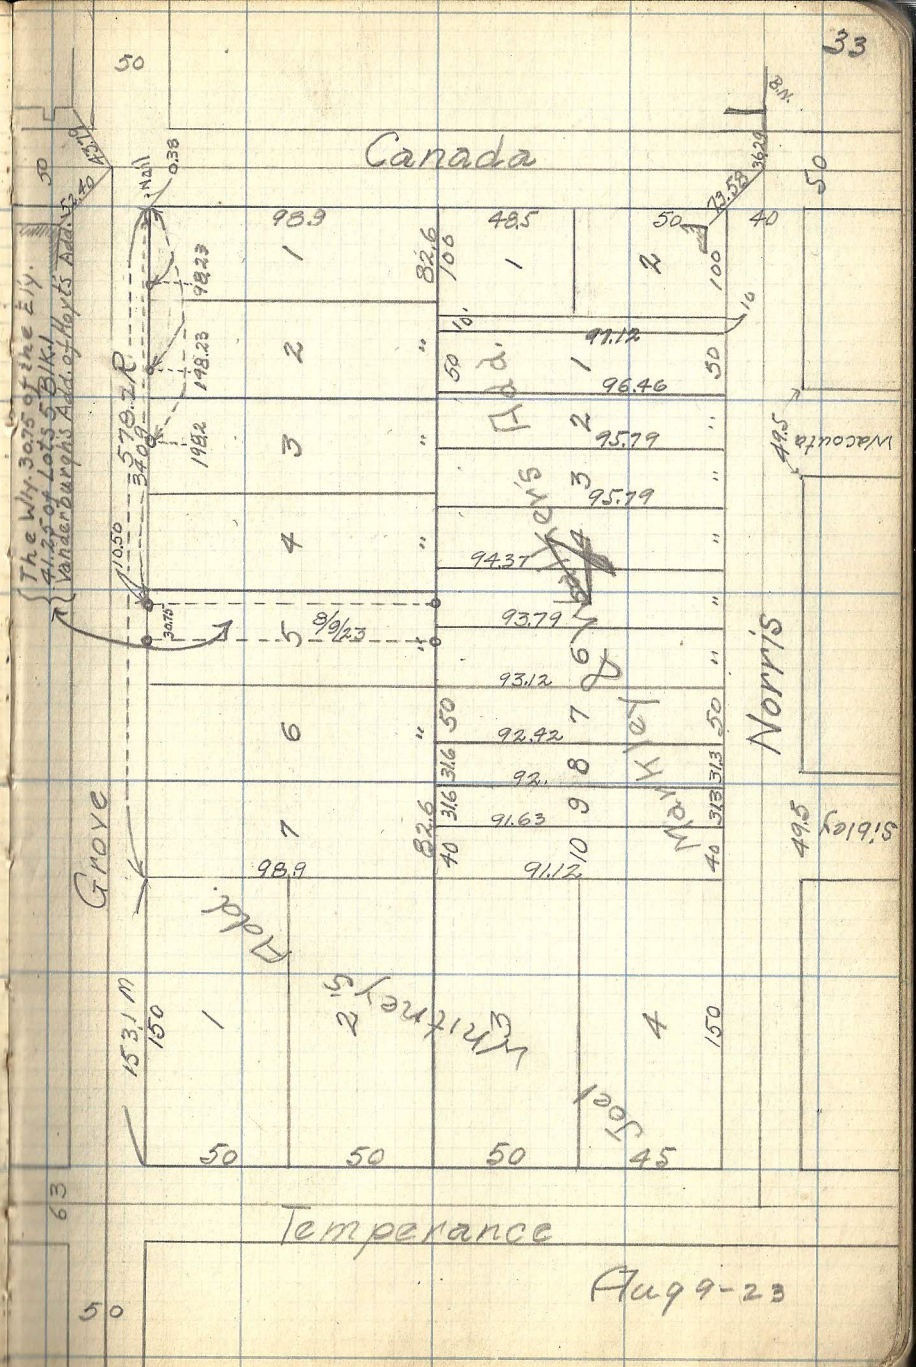
Block 59