


Fairview 266.62 R

266.46 M

66

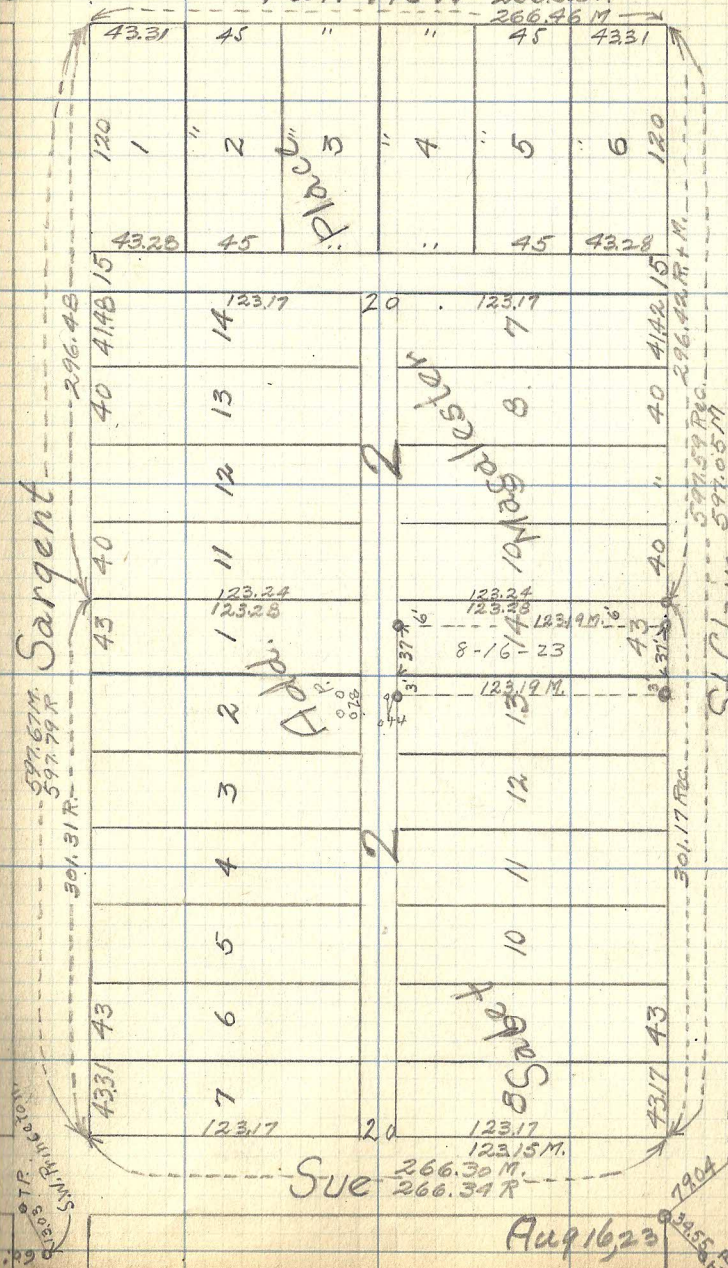

Sargent

St Clair

Sue

597.67 M
597.79 R
301.31 R

296.48

597.59 Rec.
597.05 M


SUB
G.P.P.
S.M.P.
S.M.S.

90°
0.36

60