


Milford


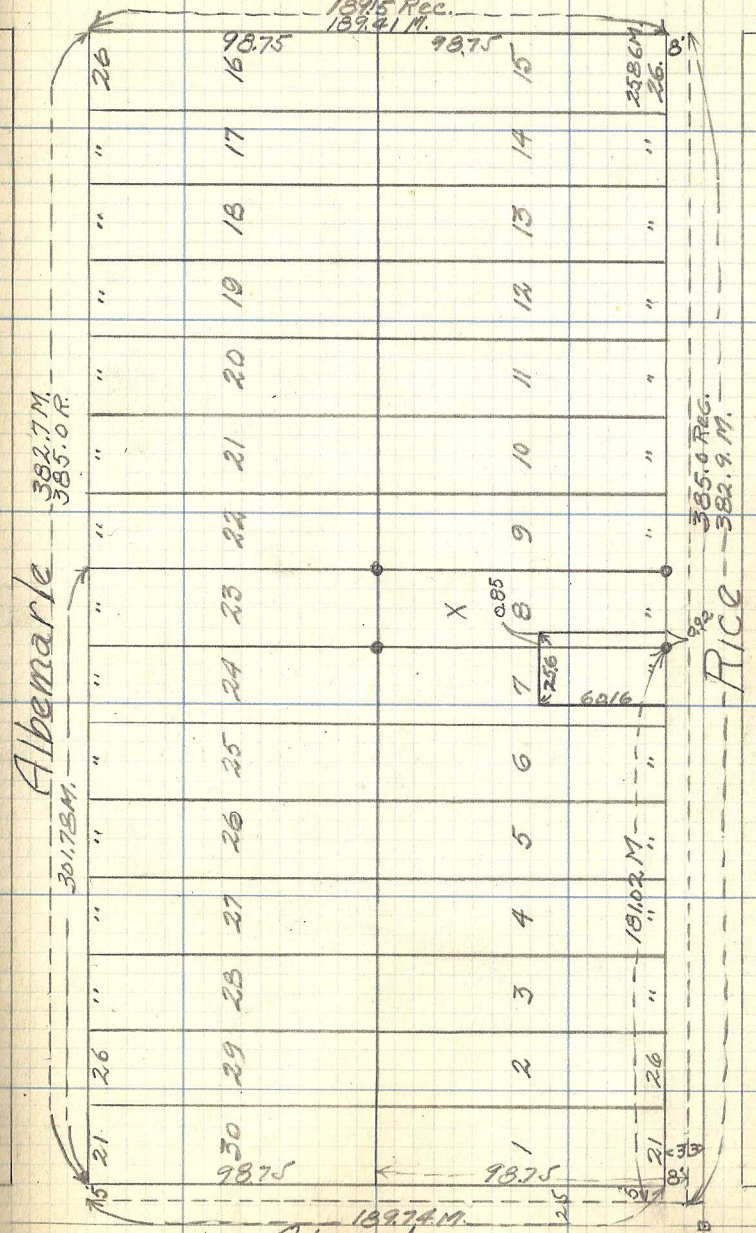

Albemarle

382.7 M.  
385.0 R.

Atwater

Aug 16-28

385.6 Rec.  
382.9 M.

RICE

McKenty's Outlots Bk. 3