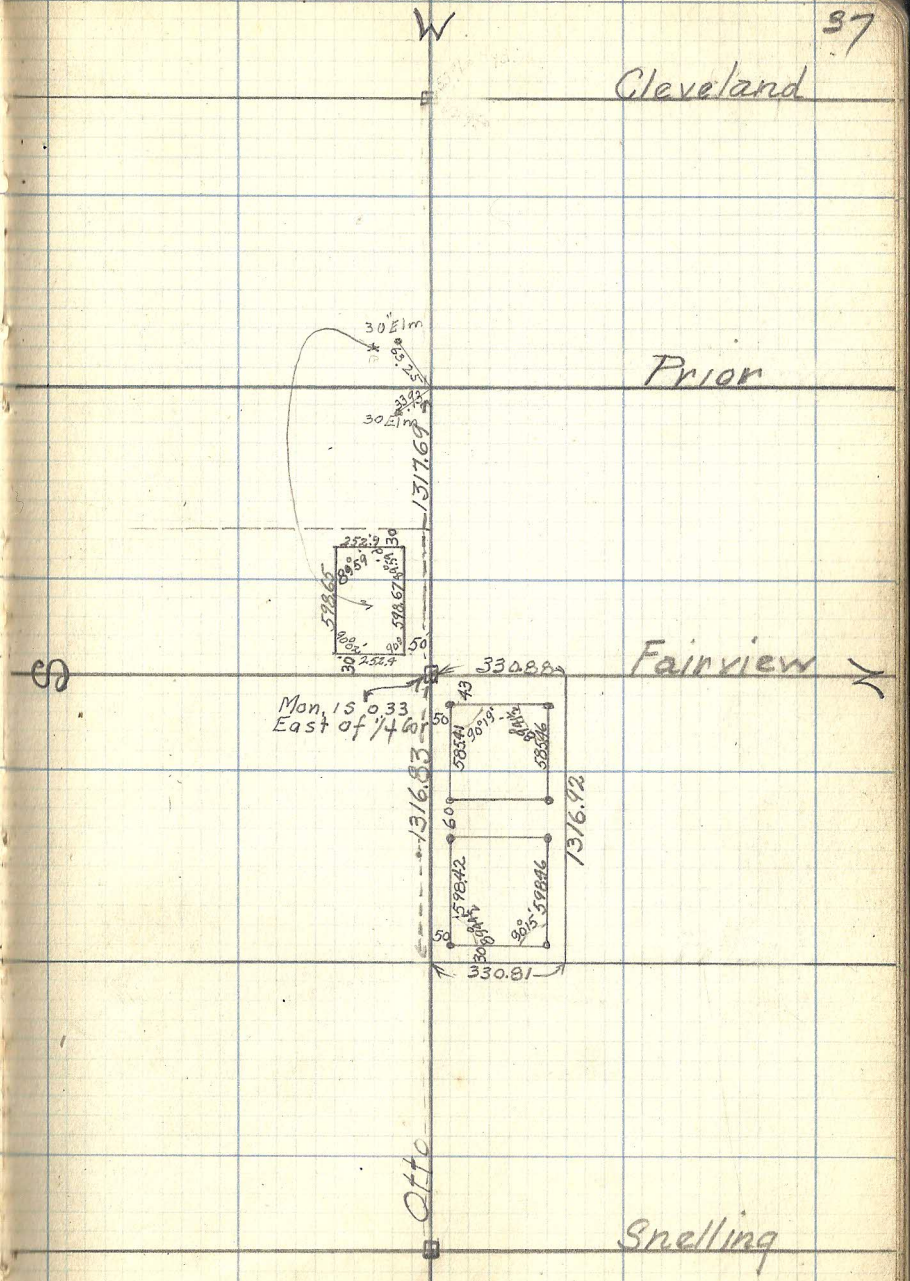
W
Cleveland
Prior
Fairview
S
N
Snelling
Otto
30" Elm
30" Elm
1317.69
330.88
Mon. 15 0.33
East of 1/4 Cor
1316.83
1316.92
330.81
598.65
598.67
252.9
252.4
585.41
585.46
598.42
598.46
90°19'
90°15'
43
50
60
30