


Oxford Aug. 23. 23 '70

St. Anthony

Chatsworth

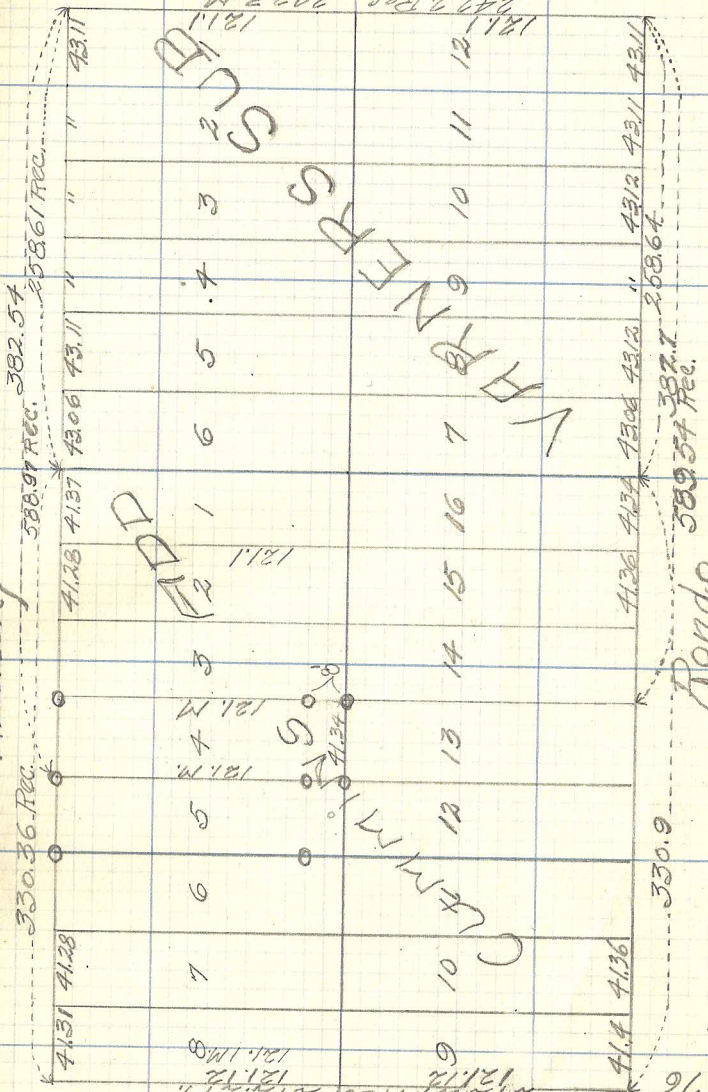

242.24 Rec. 242.24 M. 12.12
















41.4 41.36

330.9

41.36 41.34 43.06 43.12

43.12 258.64

43.12 43.11 43.11





