

2016

120

4617923

25 21

25

"

"

"

"

"

"

"

25

110

45x12.5

10

11

122.5

12

13

14

15

16

17

18

19

20


122.5

Merrill's Div. of Rice St. Villas Bk. 5

Wheelock Parkway

60

120

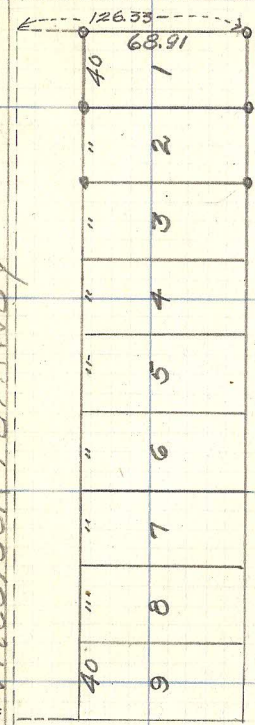

Park Ave

20

20

20

20

20

20

20

20

20

20

20

20

20

20

20

20

Rice St.

Oct. 22-23

60

Sy. Hot.

Towd Ave W.

60

42