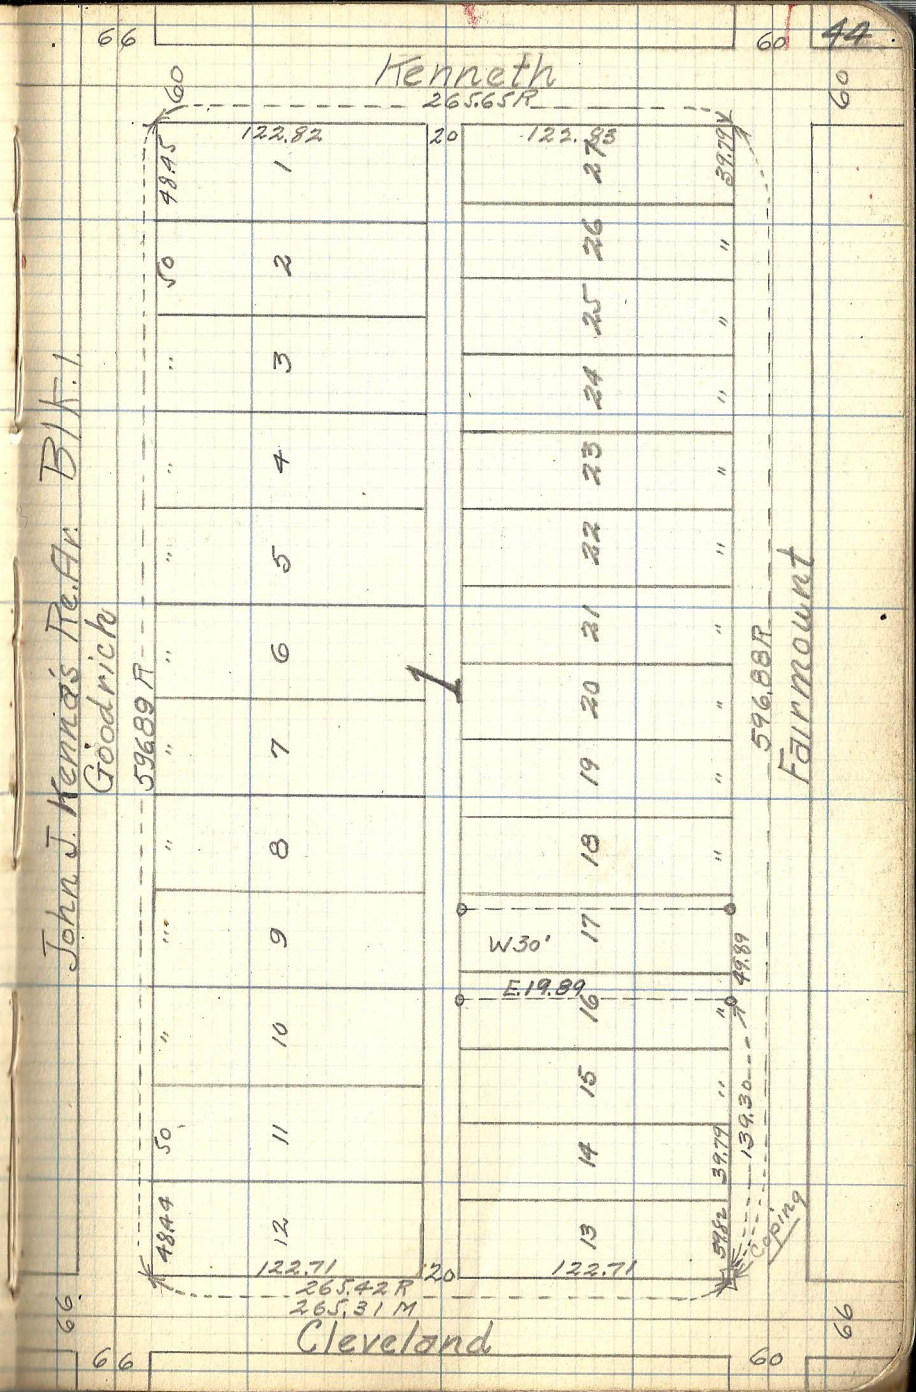
Kenneth
265.65R
122.82
122.83
48.45
32.79
1
2
3
4
5
6
7
8
9
10
11
12
13
14
15
16
17
18
19
20
21
22
23
24
25
26
W.30'
E.19.89
48.89
139.30
39.79
Coping
48.44
122.71
122.71
265.42R
265.31M
Cleveland
John J. Kennas Re. Ar. Blk. 1
Goodrich
596.89R
Fairmount
66
60