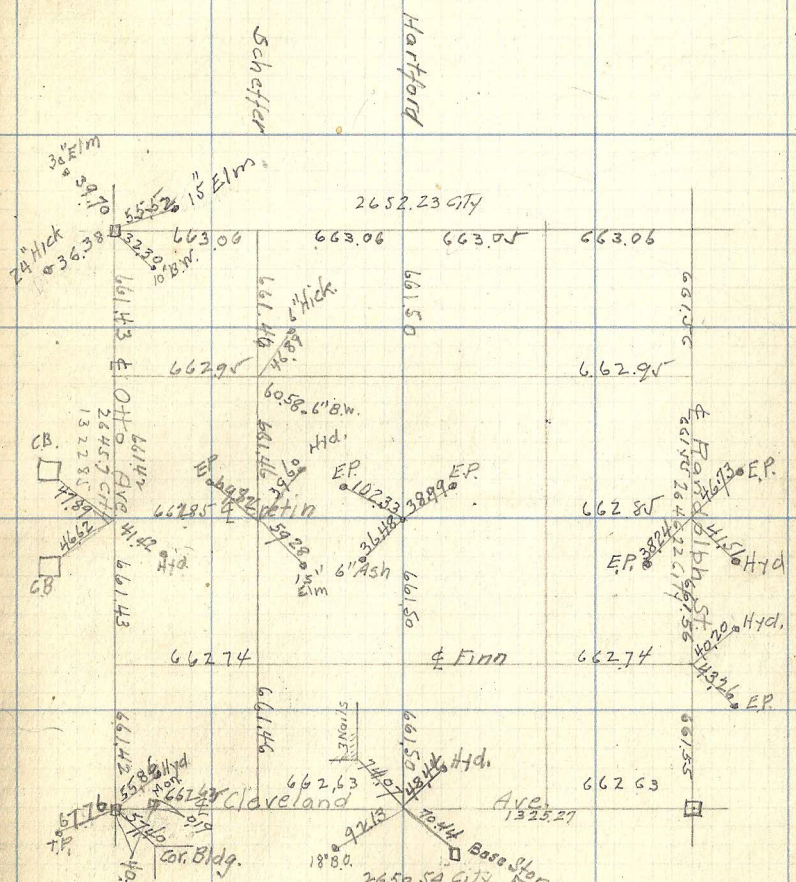
Hartford
2652.23 City
663.06
663.06
663.06
663.06
36" Elm
15" Elm
24" Hick
Hick.
661.43
662.95
662.95
60.58 6" B.W.
Otto
Hyd.
CB.
E.P.
E.P.
E.P.
E.P.
Ash
Hyd.
Hyd.
Hyd.
Hyd.
Hyd.
CB
Hyd.
Martin
Ave.
Finn
Cleveland
Ave.
Cor. Bldg.
Base Stone
2650.54 City
662.74
662.74
662.85
662.85
662.63
662 63
661.42
661.43
661.43
661.43