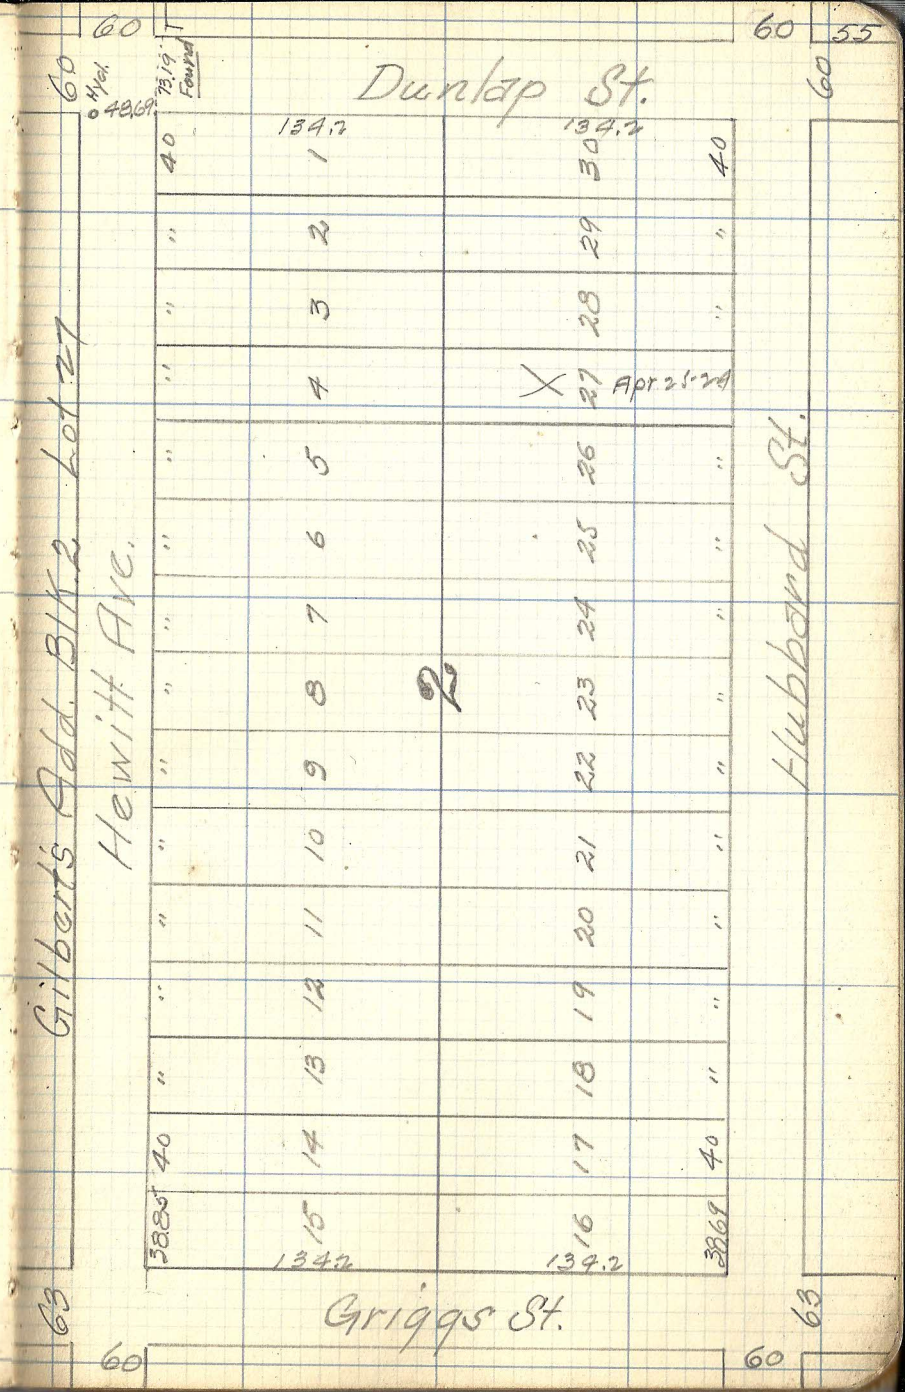
Dunlap St.
Gilberts Add. Blk 2 Lot 27
Hewitt Ave.
Hubbard St.
Griggs St.
134.2
134.2
134.2
134.2
38.82
38.68
40
40
40
40
60
60
60
60
60
60
63
63
55
Hyd.
48.69
75.19
Found
X
Apr 2-24
1
2
3
4
5
6
7
8
9
10
11
12
13
14
15
16
17
18
19
20
21
22
23
24
25
26
27
28
29
30