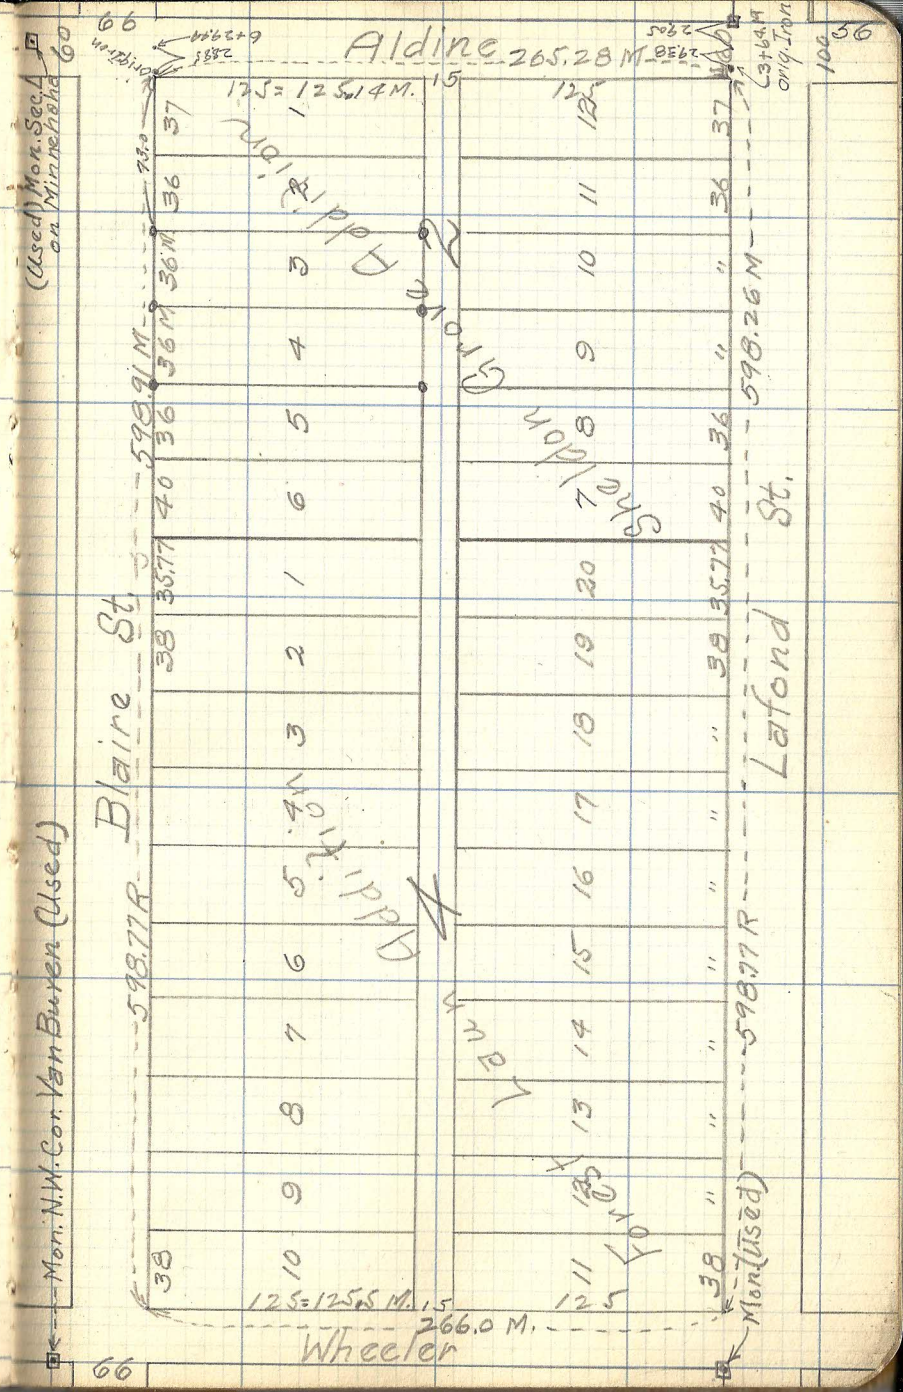

Aldine
265.28 M
125 = 125.14 M.
Blaire St.
598.91 M
598.77 R
Lafond St.
598.26 M
Sheldon Grove Addition
Forest Lawn Addition
Wheeler
266.0 M.
125 = 125.5 M.
Mon. N.W. Cor. Van Buren (Used)
(Used) Mon. Sec. 1 on Minnehaha
Mon. (Used)
Orig. Iron