


West St. Paul Proper 80

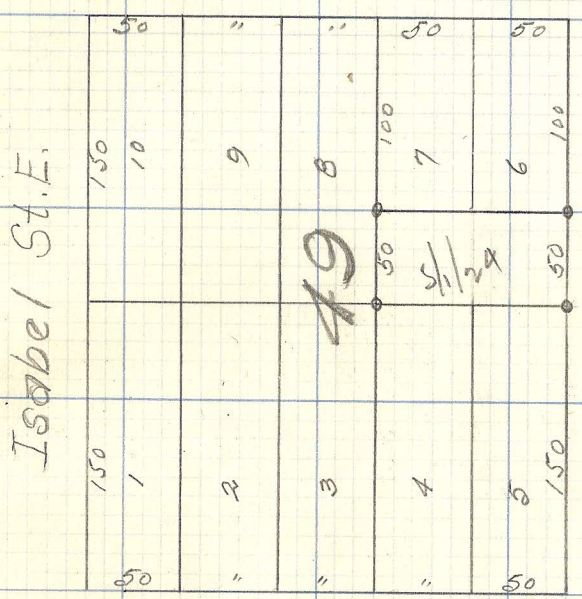

60

Greenwood Ave.

60

80

80

Clinton Ave.

60

60

80

