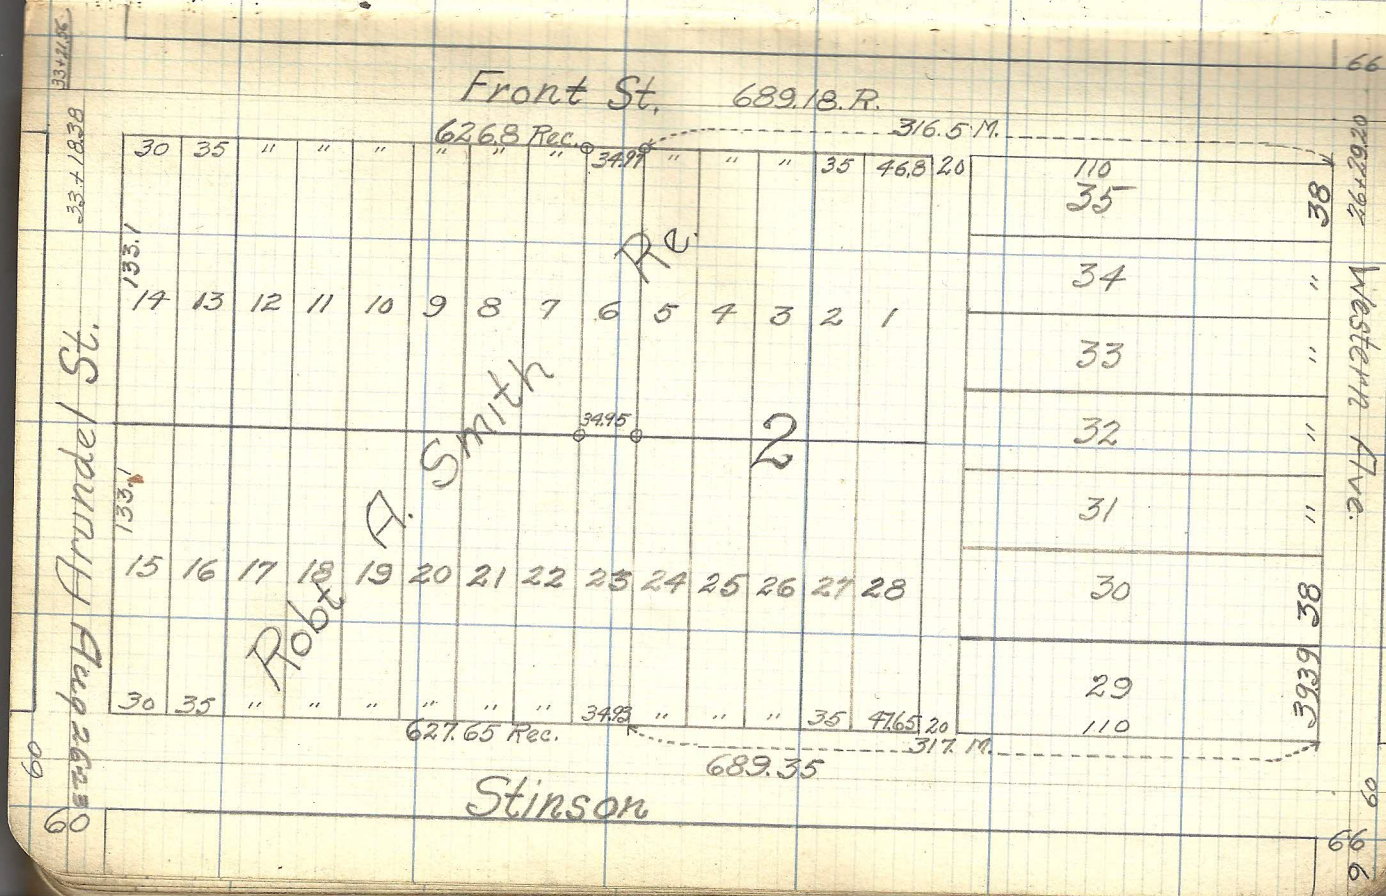

Front St.
689.18 R.
626.8 Rec.
316.5 M.
30 35 " " " " " " 34.97 " " " 35 46.8 20
110
35
38
34
33
32
31
30
29
110
Western Ave.
26+29.20
133.1
14 13 12 11 10 9 8 7 6 5 4 3 2 1
Re.
Robt A. Smith
34.95
2
133.1
15 16 17 18 19 20 21 22 23 24 25 26 27 28
30 35 " " " " " " 34.93 " " " 35 47.65 20
627.65 Rec.
317 M.
689.35
Stinson
Arundel St.
33+21.56
33+18.38
Aug 26-23
60
66