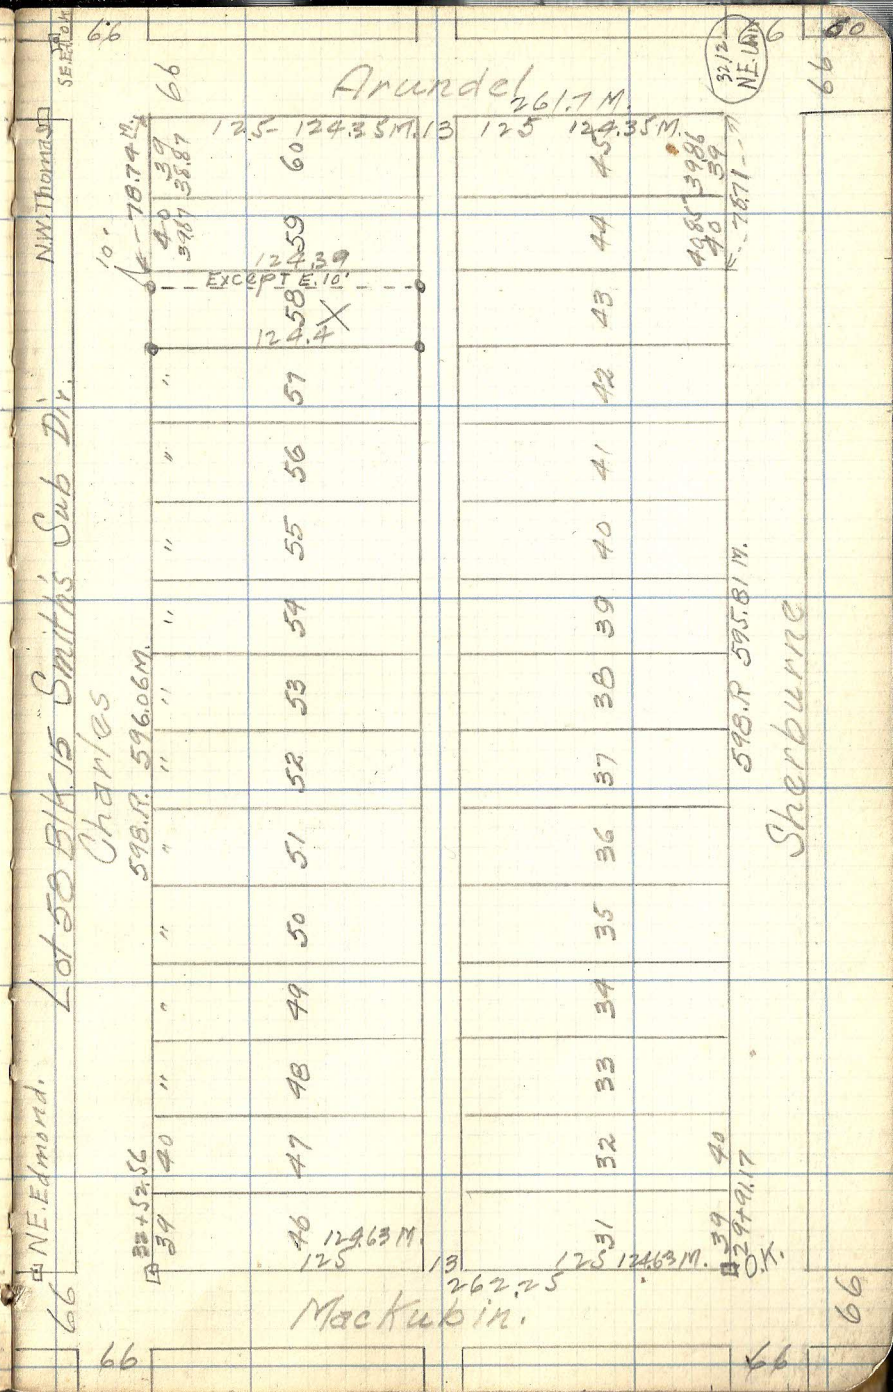

Arundel
261.7 M.
125-124.35 M.
13
125 124.35 M.
Lot 58 Blk 15 Smith's Sub Dir.
Charles
Sherburne
Mackubin.
N.W. Thomas
NE. Edmond.
SE. Edmond
598.R. 596.06 M.
598.R 595.81 M.
Except E. 10'
124.39
124.4
124.63 M.
125
13
262.25
125 124.63 M.
O.K.
32.12 NE. Lat.
66