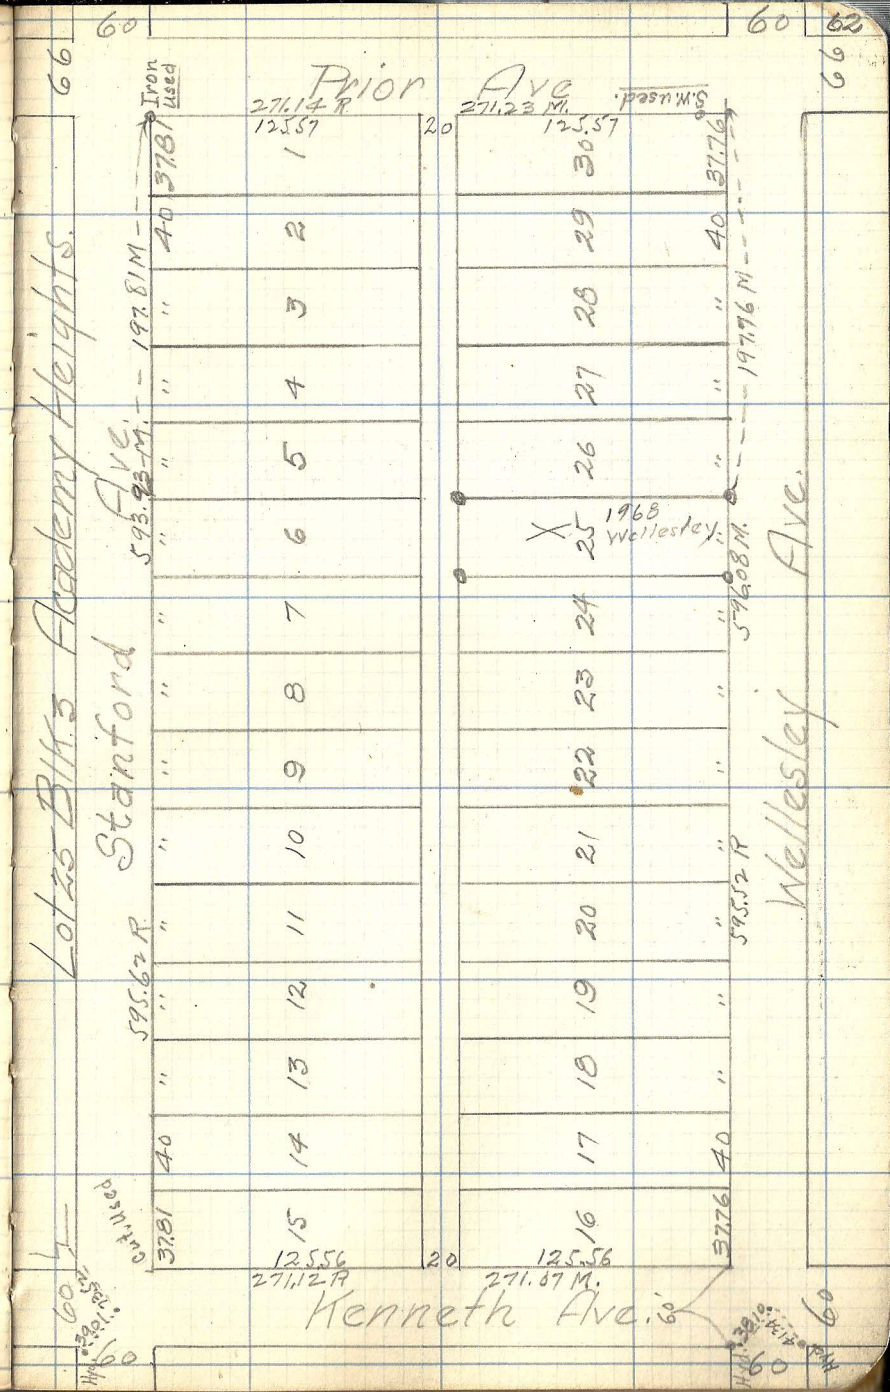

Lot 25 Blk 3 Academy Heights
Prior Ave
Stanford Ave.
Wellesley Ave.
Kenneth Ave.
Iron Used
S.W. Used
271.14 R.
271.23 M.
125.57
125.56
271.12 R
271.07 M.
593.93 M.
596.08 M.
595.62 R
595.52 R
197.81 M
197.76 M
1968 Wellesley
Cut Used