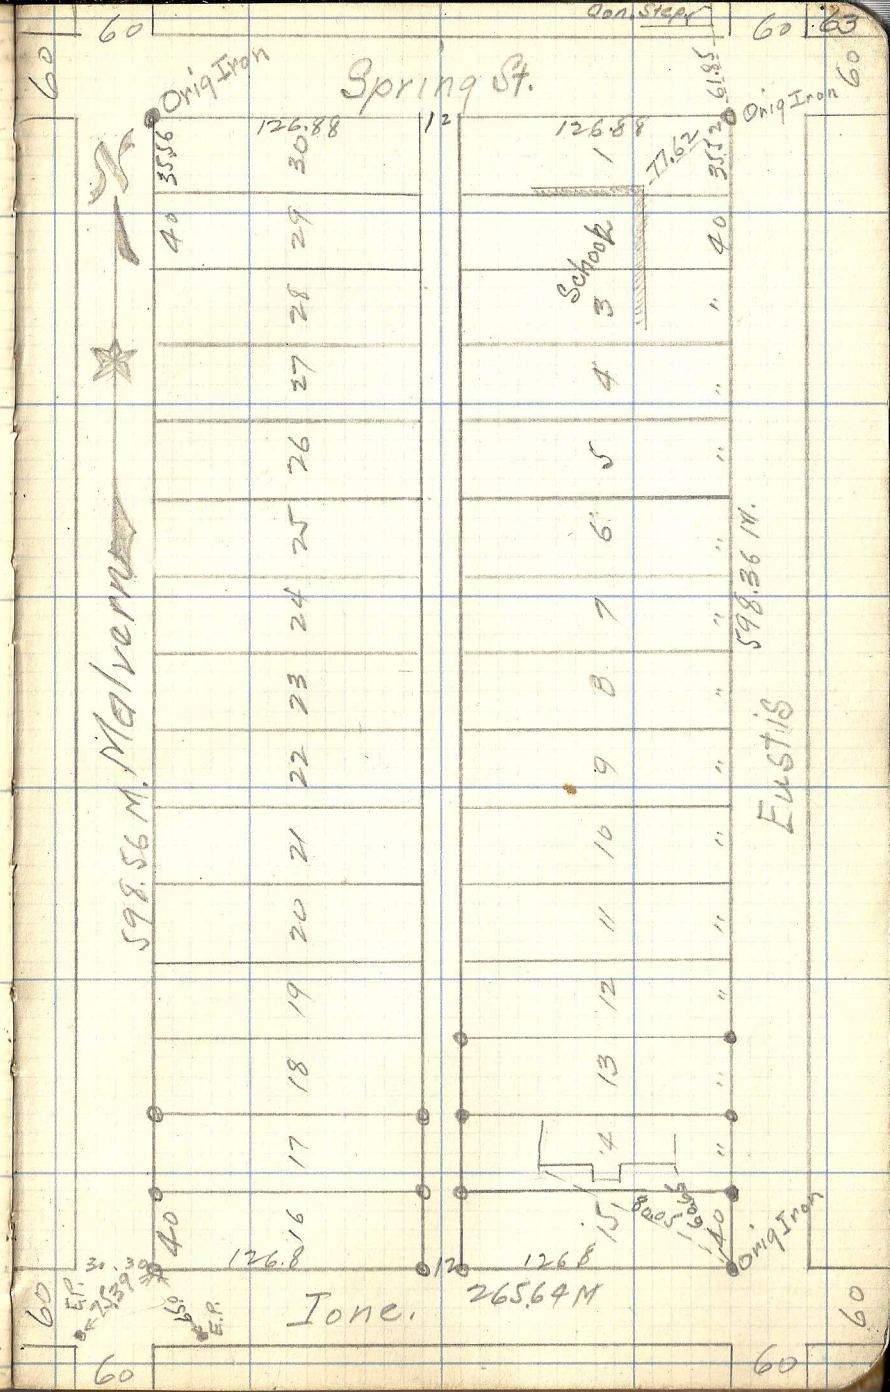Lauderdales E. Side Add. Blk 10