


Manuels Add 131K2

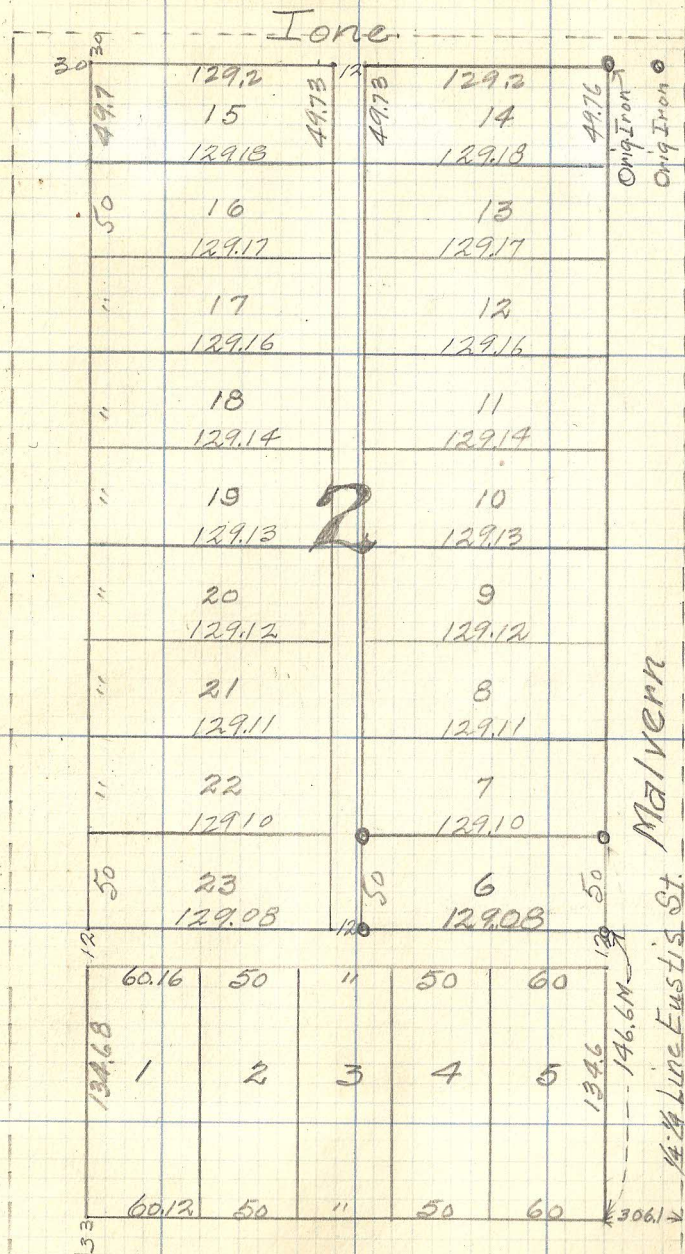

See 17 T29 R23
See 20 T29 R23