


66 Lot 21 Blk 4 Foundry Add.

Burgess St.

6/26/24 Arundel

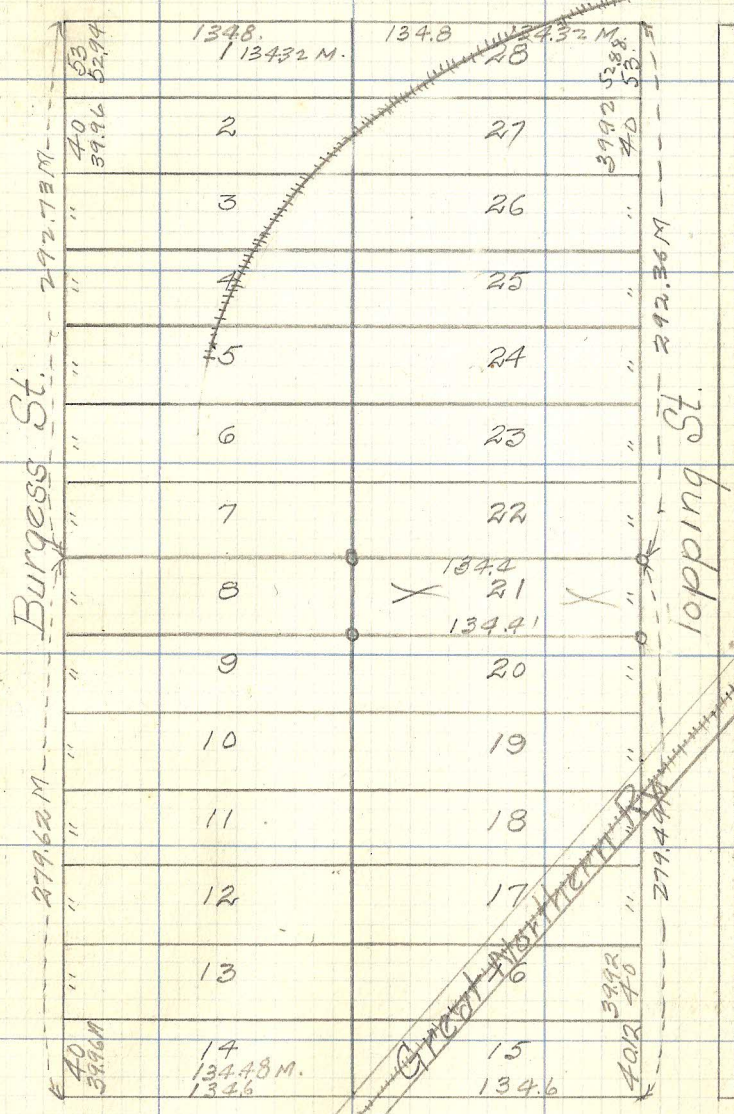

MacKubin

60

60

66

60

66