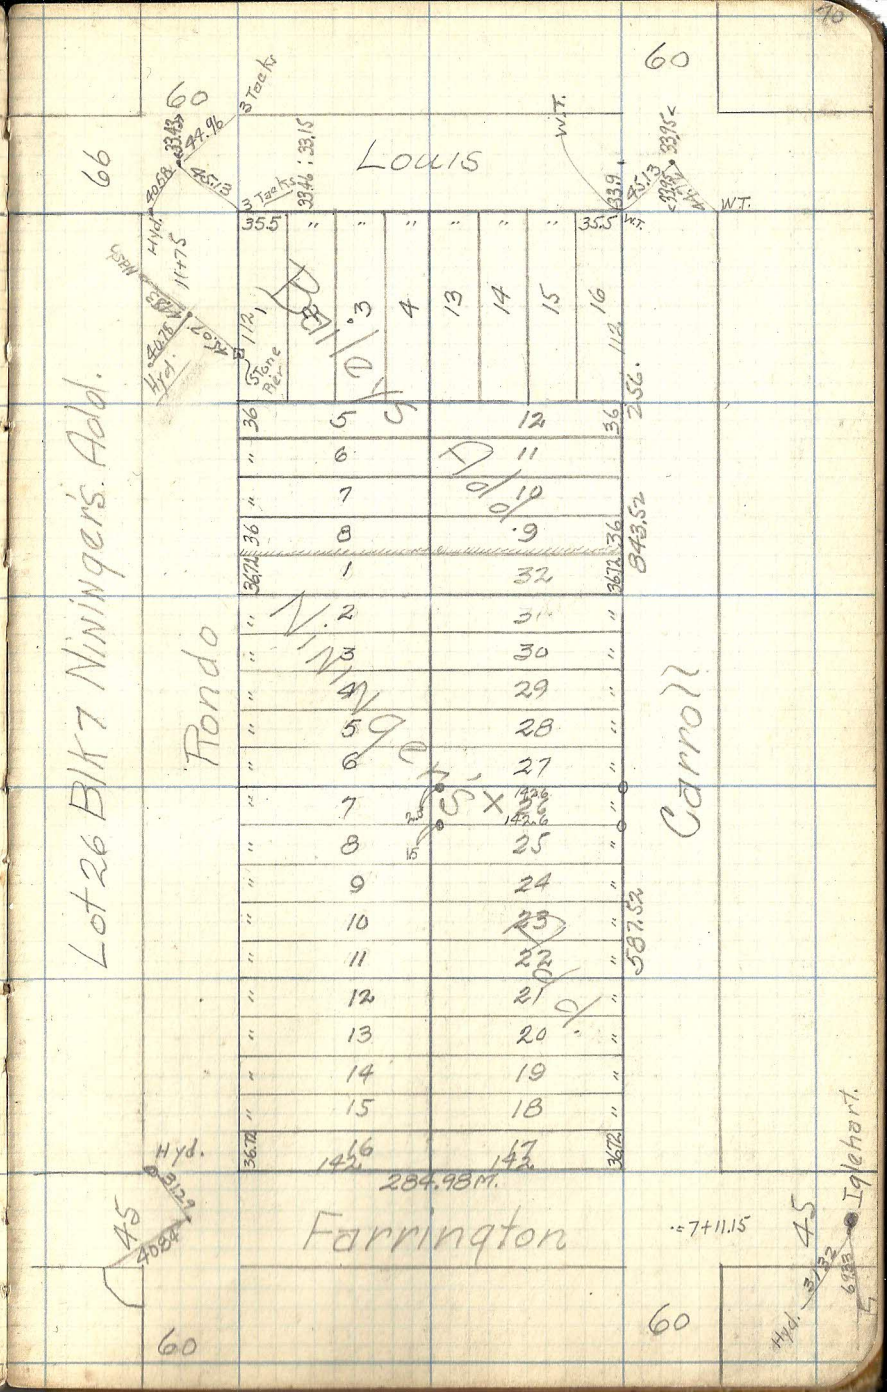
Louis
Lot 26 Blk 7 Ninivgers Add.
Rondo
Carroll
Farrington
Iglehart
W.T.
Hyd.
Stone
3 Track
60
66
45
284.98M.
843.52
587.52
256.
112
35.5
36
36.72
14.46
14.43