


Otto
Anna Mandehr
5.48 Acres.

Cottage St. 71

66

Lot 8 + South 1/2 Lot 7 Penny Hill Add.

Searle St.

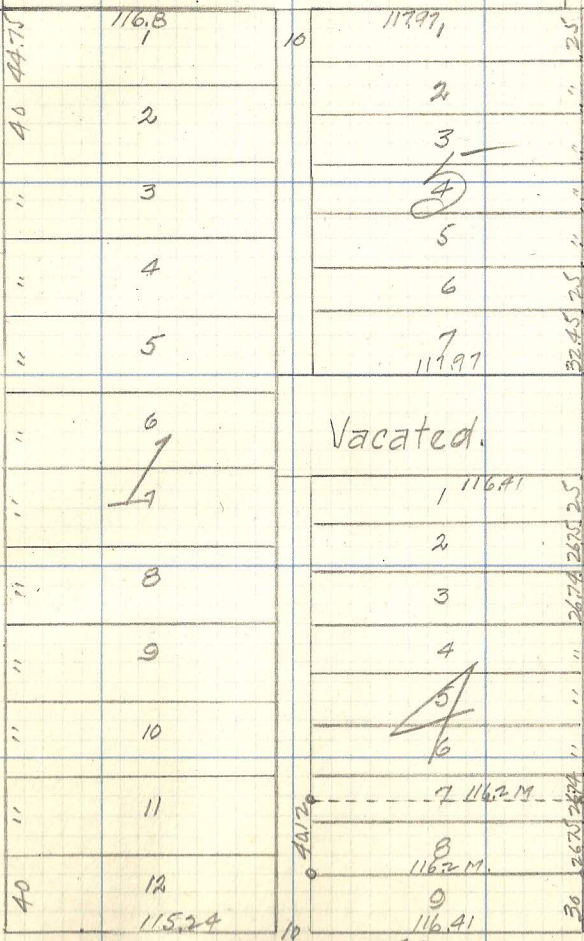

Vacated.

Clear St.

Payne

Ivy St.

6+19.57

66

66

66