


Lot 8 Blk. 6 Lynen D. Baird Add.

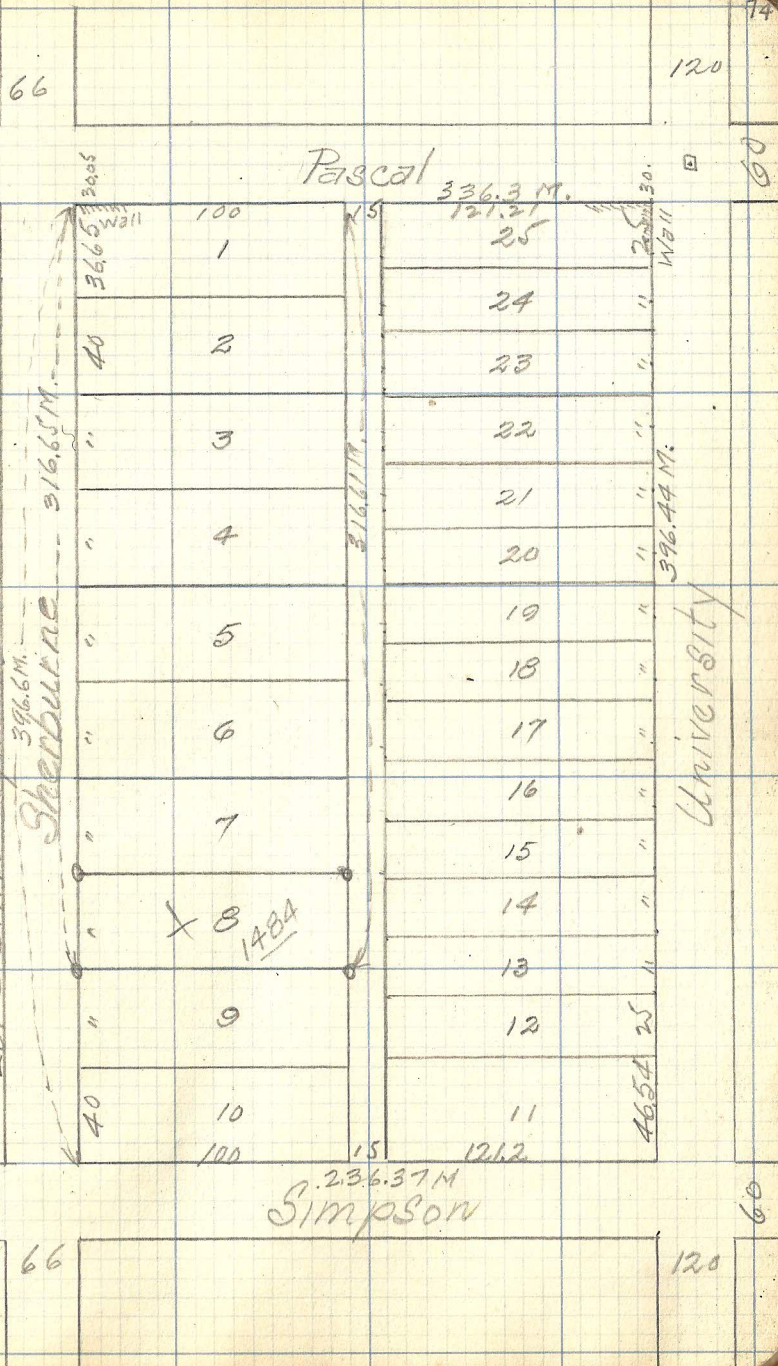

60

60

66

66

366.5

366.5

40

"

"

"

"

"

"

"

"

"

"

"

"

40

100

100

1

2

3

4

5

6

7

8

9

10

100

Pascal

336.3 M.

121.21

25

24

23

22

21

20

19

18

17

16

15

14

13

12

11

121.2

15

316.11 M.

15

236.37 M
Simpson

30

Well

"

"

"

"

"

"

"

"

"

"

"

"

"

25

46.54

396.44 M.

University

120

120

74

60

60