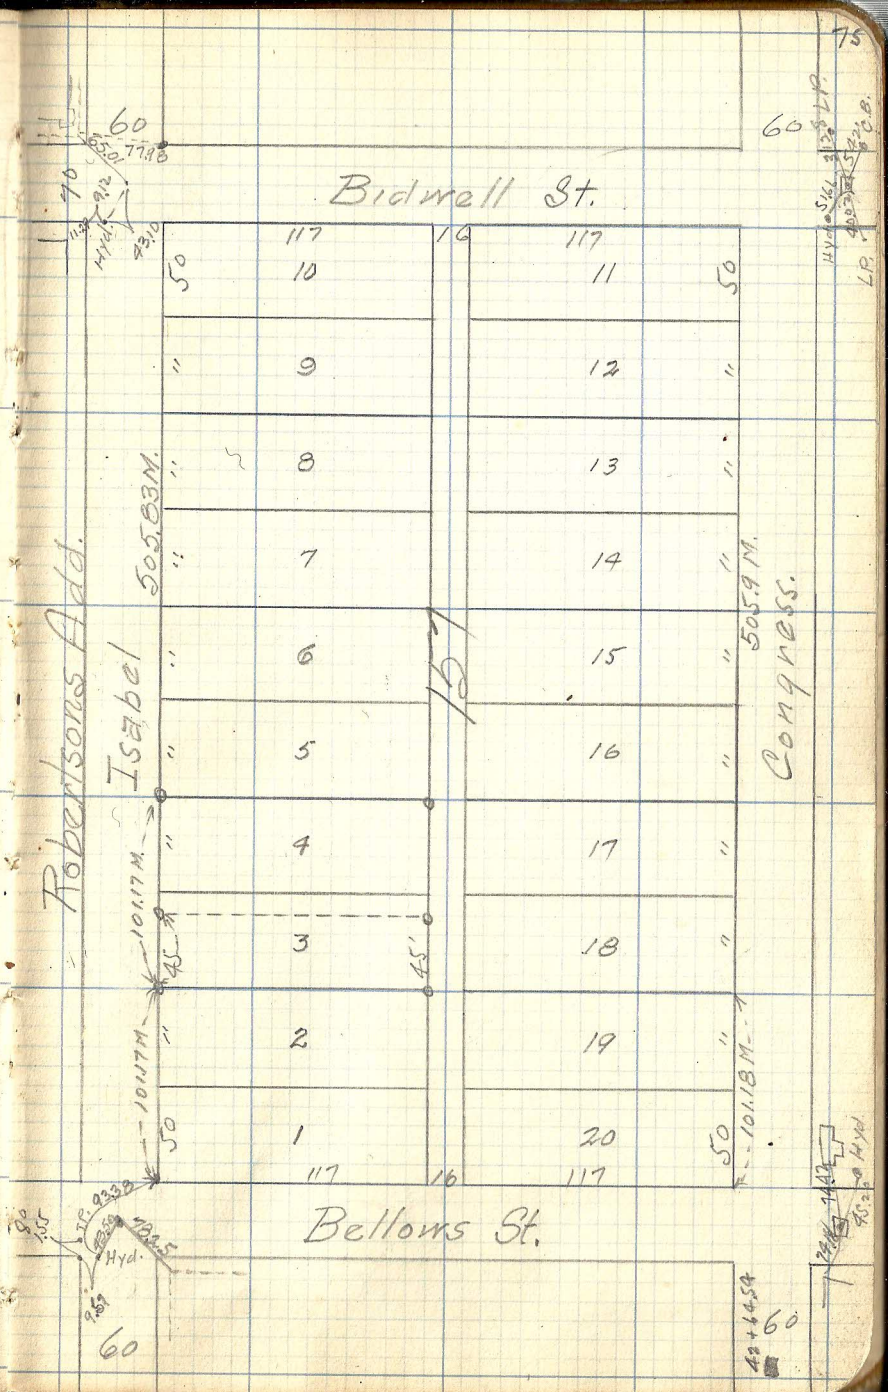
Bidwell St.
Robertsons Add.
Isabel
505.83M.
505.9M.
Congress.
Bellons St.
Hyd.
60
117
16
50
45'
10
11
12
13
14
15
16
17
18
19
20
9
8
7
6
5
4
3
2
1
101.17M.
101.18M.
90°
155
I.C. 93.3
79.2
9.59
43+64.54