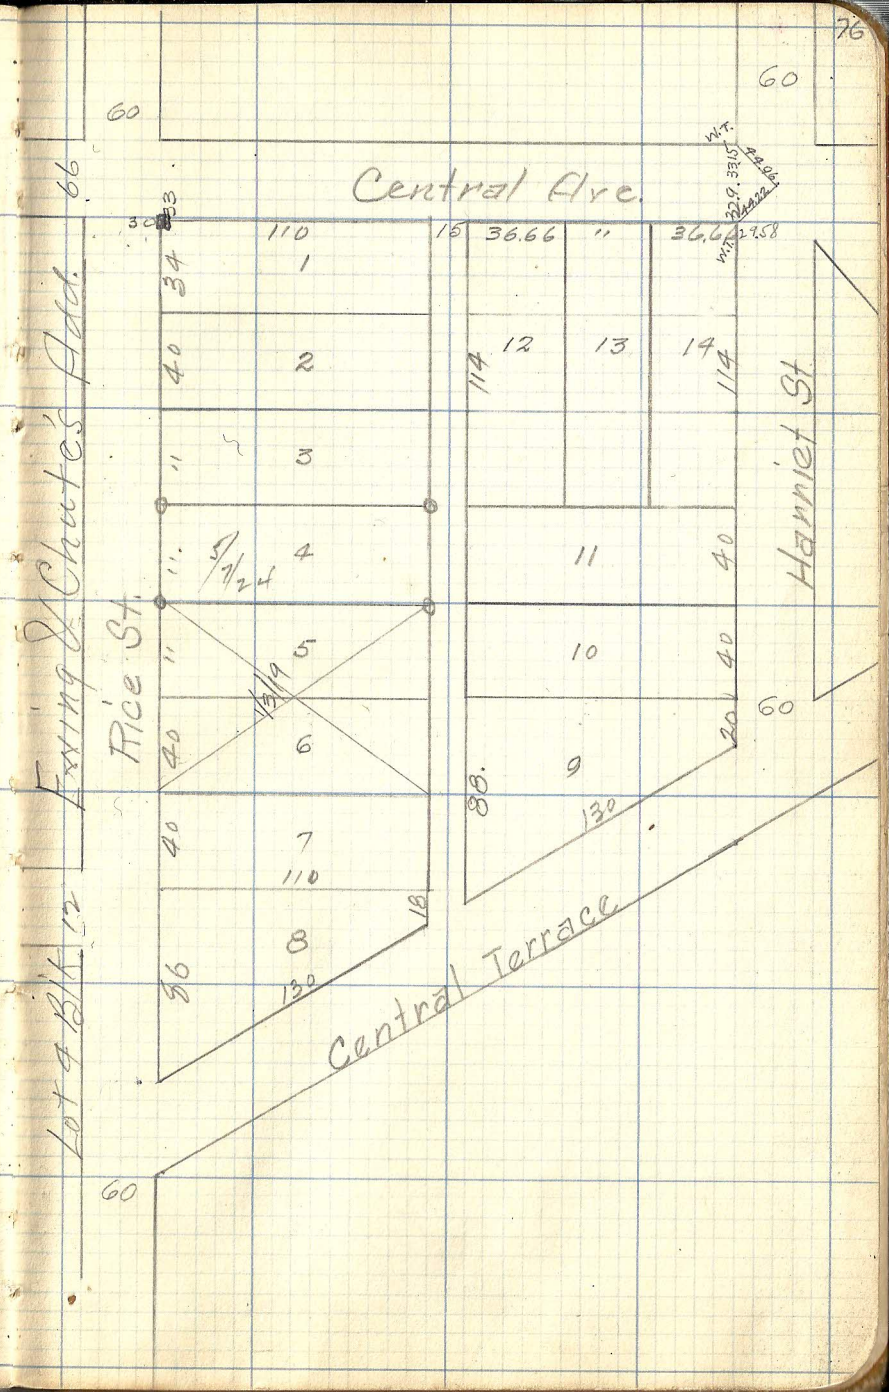
Central Ave.
Rice St.
Harriet St
Central Terrace
Lot 4 Blk 12
60
66
110
36.66
114
40
130
88.
96
W.T.
329.
33.5
29.58
1
2
3
4
5
6
7
8
9
10
11
12
13
14